

WELL PLUGGING RECORD

Give All Information Completely
Make Required Affidavit
Mail or Deliver Report to:
Conservation Division
State Corporation Commission
211 No. Broadway
Wichita, Kansas

Ellis County, Sec. 3 Twp. 13S Rge. (X) 18(W)

Location as "NE/CNW/SW" or footage from lines NW SE NW

Lease Owner Clinton Oil Co. & Jones-Gebert Oil, Inc.

Lease Name Saunders Well No. 1

Office Address 205 Central Bldg., Wichita, Kansas

Character of Well (completed as Oil, Gas or Dry Hole) Dry Hole

Date well completed Feb. 14 19 64

Application for plugging filed Feb. 14 19 64

Application for plugging approved Feb. 14 19 64


Plugging commenced Feb. 14 19 64

Plugging completed Feb. 14 19 64

Reason for abandonment of well or producing formation Dry Hole

If a producing well is abandoned, date of last production 19

Was permission obtained from the Conservation Division or its agents before plugging was commenced? Yes

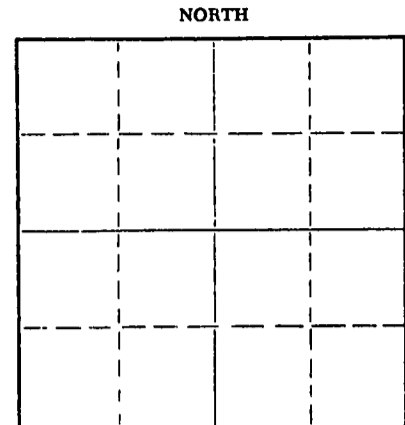

Name of Conservation Agent who supervised plugging of this well Eldon Petty, Hays, Kansas

Producing formation Depth to top Bottom Total Depth of Well 3750' Feet

Show depth and thickness of all water, oil and gas formations.

OIL, GAS OR WATER RECORDS

CASING RECORD

Table with 7 columns: FORMATION, CONTENT, FROM, TO, SIZE, PUT IN, PULLED OUT. Row 1: SIZE 8-5/8", PUT IN 190'.

Describe in detail the manner in which the well was plugged, indicating where the mud fluid was placed and the method or methods used in introducing it into the hole. If cement or other plugs were used, state the character of same and depth placed, from feet to feet for each plug set.

Set plug @550' w/20 sx., plug @160' w/20 sx.
plug @35' w/10 sx.

RECEIVED
STATE CORPORATION COMMISSION

FEB 18 1964

02-18-1964

CONSERVATION DIVISION
Wichita, Kansas

(If additional description is necessary, use BACK of this sheet)

Name of Plugging Contractor Jones-Gebert Oil, Inc.

Address 205 Central Bldg., Wichita, Kansas

STATE OF Kansas, COUNTY OF Sedgwick, ss. George R. Jones

(owner or operator) of the above-described well, being first duly sworn on oath, says: That I have knowledge of the facts, statements, and matters herein contained and the log of the above-described well as filed and that the same are true and correct. So help me God.

(Signature) [Signature]

205 Central Bldg., Wichita, Kansas

(Address)

SUBSCRIBED AND SWORN TO before me this 17 th day of February, 19 64

My commission expires January 8, 1968

[Signature] Lois J. McCoy Notary Public.

DRILLERS' LOG

Company: Clinton Oil & Jones-Gebert Oil, Inc.
 Contractor: Jones-Gebert Oil, Inc.
 Farm: #1 Saunders, NW SE NW
 Sec. 3-13S-18W
 Ellis Cb., Kansas
 Commenced: 1/31/64
 Completed: 2/14/64
 Casing: 190' of 8-5/8" w/160 sx.

0	-	75	Surface
75	-	169	Red bed
169	-	570	Shale & shells
570	-	873	Shale
873	-	1425	Shale
1425	-	1620	Anhydrite, shale
1620	-	1980	Shale & shells
1980	-	2100	Shale & lime
2100	-	2270	Shale & lime
2270	-	2415	Lime & shale
2415	-	2505	Lime & shale
2505	-	2660	Lime & shale
2660	-	2765	Lime & shale
2765	-	2880	Lime & shale
2880	-	3000	Lime & shale
3000	-	3040	Lime & shale
3040	-	3130	Lime & shale
3130	-	3233	Lime & shale
3233	-	3340	Lime w/shale
3340	-	3393	Lime & shale
3393	-	3455	Lime & shale
3455	-	3485	Lime
3485	-	3530	Lime
3530	-	3534	Lansing
3534	-	3565	Lime
3565	-	3645	Lime
3645	-	3720	Lime, shale
3720	-	3750	Arbuckle
		3750	Rotary Total Depth

RECEIVED
 STATE GEOLOGICAL SURVEY
 FEB 18 1964
 02-18-1964
 CONSERVATION DIVISION
 Wichita, Kansas

I, George R. Jones, do hereby certify that the above and foregoing is a true and correct copy of the log of the #1 Saunders, NW SE NW, Sec. 3-13S-18W, Ellis Co., Kansas, as reflected by the files of Jones-Gebert Oil, Inc.

George R. Jones

 GEORGE R. JONES

State of Kansas)
) ss:
 County of Sedgwick)

Subscribed and sworn to before me, a Notary Public, in and for Sedgwick County, Kansas this 17th day of February, 1964.

My Commission Expires:
 January 8, 1968

Lois J. McCoy

 Lois J. McCoy, Notary Public