

STATE OF KANSAS
STATE CORPORATION COMMISSION


WELL PLUGGING RECORD

FORMATION PLUGGING RECORD

Strike out upper line
when reporting plug-
ging off formations.

Give All Information Completely
Make Required Affidavit
Mail or Deliver Report to:
Conservation Division
State Corporation Commission
800 Bitting Building
Wichita, Kansas

NORTH

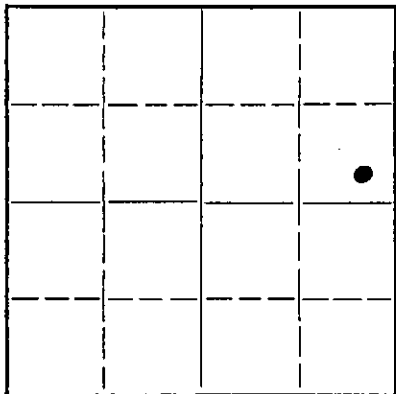

Locate well correctly on above
Section Flat

Ellis County, Sec. 3 Twp. 13 Rge. (E) 18 (W)

Location as "NE 1/4 NW 1/4 SW 1/4" or footage from lines SE NE 4

Lease Owner Sharon Drilling Co., Inc., et al.,

Lease Name Jensen Well No. 1

Office Address 352 North Broadway, Wichita, Kansas

Character of Well (completed as Oil, Gas or Dry Hole) Dry Hole

Date well completed 6/12/43 19

Application for plugging filed 6/16/43 19

Application for plugging approved 6/16/43 19

Plugging commenced 7/6/43 19

Plugging completed 7/10/43 19

Reason for abandonment of well or producing formation Dry Hole

If a producing well is abandoned, date of last production 19

Was permission obtained from the Conservation Division or its agents before plugging was commenced? Yes

Name of Conservation Agent who supervised plugging of this well Bert Stafford

Producing formation Arbuckle Depth to top 3672 Bottom 3698 Total Depth of Well 3699 Feet

Show depth and thickness of all water, oil and gas formations.

OIL, GAS OR WATER RECORDS

CASING RECORD

Formation	Content	From	To	Size	Put In	Pulled Out
Arbuckle	Barren	3672	3698	8 5/8"	190'	None
				5 1/2" OD	3672'	2694'

Describe in detail the manner in which the well was plugged, indicating where the mud fluid was placed and the method or methods used in introducing it into the hold. If cement or other plugs were used, state the character of same and depth placed, from _____ feet to _____ feet for each plug set.

Cement 3699' To 3655' This plug placed 6/16/43
Mud 3655' To 950'
Wood Plug and
Bridge Solid 950' To 925'
Cement 925' To 900'
Mud 900' To 200'
Bridge and Cement 200' To 165'
Mud 165' To 20'
Cement 20' To cellar base

JUL 25 1943
00-28-1943

SEC. 3, TWP. 13, RGE. 18 W
78-40

(If additional description is necessary, use BACK of this sheet)

Correspondence regarding this well should be addressed to Sharon Drilling Company, Inc.,
Address 352 North Broadway, Wichita 2, Kansas

STATE OF KANSAS, COUNTY OF SEDGWICK, ss.
D. S. Cates, (employee of owner)

being first duly sworn on oath, says: That I have knowledge of the facts, statements, and matters herein contained and the log of the above-described well as filed and that the same are true and correct. So help me God.

(Signature) D. S. Cates

Wichita, Kansas (Address)

SUBSCRIBED AND SWORN to before me this 26th day of July 1943

My commission expires May 4-1947 Notary Public

Lebsack, Alexander et al.

No. 1 Jensen - SE NE $\frac{1}{4}$ 3-13-18W.,
Ellis County, Kansas

Commenced: 5/14/43
Completed: 5/29/43 With rotary
Completed with cable tools - 6/12/43

CASING RECORD:

Initial Potential: Dry
T. D. - 3698'

8 5/8" @ 190' cemented with 100 sax
5" 3672 " 100 "

LOG

TOPS

Surface	10
Shale Shells	190
Shale & Shells	375
Sand & Shale	420
Shale	550
Sand & Shale	840
Sand	1040
Shale	1210
Red rock & Shale	1387
Anhydrite	1430
Red rock & Shale	1490
Shale & Shells	1770
Shale & Salt	1965
Shale & Shells	2050
Broken Lime	2450
Lime - sand	2485
Line - broken	2525
Shale	2560
Shale & Shells	2590
Sand	2605
Shale, sand & Shells	2655
Shale & Shells	3080
Shale	3117
Lime	3354
Shale & Shells	3396
Lime	3405
Shale	3425
Lime	3653
Shale	3663
Shale & Chert	3668
Arbuckle	3676
Note	3676 & 3680

Topeka 3135
Lansing 3422
Base KC Ls 3657 corrected
Top of Shale congl. trace of
chert 3667 corrected
Top Arbuckle 3672 corrected

Rot TD 3680 derrick floor.

Show oil in top of Arbuckle

CABLE TOOL LOG

Dolomite 3680-82
Show free oil 3682 approx. 10 gals over
night.
Acidized 500 gals. acid 3682 TD no in-
crease
Hard dolomite 3682-92
Fine sugary dolomite 3692-94
6 bailers of water per hour 3694
Let set 12 hours at 3694 had 450 feet
of water - drilled deeper
Soft sugary dolomite 3694-98 TD HFW
Water increase from 450 to 800' in 1 Hr.,
while drilling and bailing.
D & A.

Rot TD
Derrick floor

I hereby certify that to the best of my knowledge and belief the above
log is true and correct.

SHARON DRILLING COMPANY, INC.,

PLUGGING
FILE 3-13-18W BY
BOOK PAGE-78-40

M. J. Bean

State of Kansas }
County of Sedgwick } ss.

Subscribed and sworn to before me a Notary Public, in and for said State
and County, this 14 day of June, 1943.

STATE OF KANSAS
COMMISSIONER
JUN 17 1943
REGISTRATION
DIVISION
Gemma Schidlowky
Notary Public

My commission expires:
May 4-1947