

CARD MUST BE TYPED

State of Kansas
NOTICE OF INTENTION TO DRILL

(see rules on reverse side)

240 Collection
CARD MUST BE SIGNED

6-14-85

Starting Date: June 30 1985
month day year

API Number 15- 051-24237-00-00

OPERATOR: License # 8449

* NW SW SW Sec 25 Twp 13s S, Rge 17w
(location) East West

Name McNames & Patterson

Address P.O. Box 20058

City/State/Zip Wichita, KS

Contact Person Gary Patterson

Phone 733-5750

* 990 Ft North from Southeast Corner of Section
* 4950 Ft West from Southeast Corner of Section
(Note: Locate well on Section Plat on reverse side)

CONTRACTOR: License # 5655

Name Shields Drlg

City/State Russell, Ks

Nearest lease or unit boundary line 330 feet.
County Ellis

Lease Name Braun Well# 1

Domestic well within 330 feet: yes no

Municipal well within one mile: yes no

Well Drilled For: Well Class: Type Equipment:
 Oil Swd Infield Mud Rotary
 Gas Inj Pool Ext. Air Rotary
 OWWO Expl Wildcat Cable

Depth to Bottom of fresh water feet

Lowest usable water formation Dgkote feet

Depth to Bottom of usable water 530 feet

Surface pipe by Alternate: 200

Surface pipe to be set feet

Conductor pipe if any required feet

Ground surface elevation 1963 feet MSL

This Authorization Expires 11-15-85

Approved By 5-15-85

If OWWO: old well info as follows:
Operator
Well Name
Comp Date Old Total Depth
Projected Total Depth 3600 feet
Projected Formation at TD Arbuckle
Expected Producing Formations Arbuckle

I certify that we will comply with K.S.A. 55-101, et seq., plus eventually plugging hole to K.C.C. specifications. *KWQS NE SE SE 26-15-17W*

Date 6-11-85 Signature of Operator or Agent Gary Patterson Title Partner *840 FSL 330 FEL*


Must be filed with the K.C.C. five (5) days prior to commencing well
This card void if drilling not started within six (6) months of date received by K.C.C.

RECEIVED
STATE CORPORATION COMMISSION

JUN 14 1985

06-14-1985

A Regular Section of Land
1 Mile = 5,280 Ft.
Wichita, Kansas

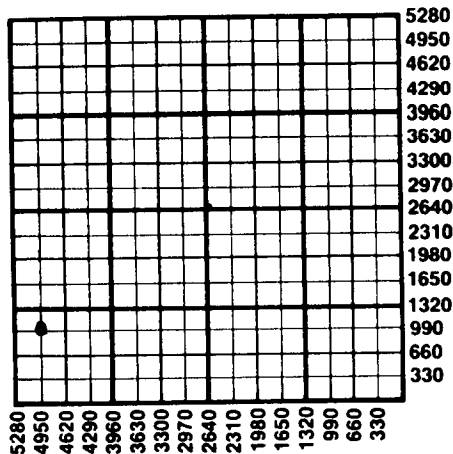

Important procedures to follow:

1. Notify District office before setting surface casing.
2. Set surface casing by circulating cement to the top.
3. File completion forms ACO-1 with K.C.C. within 90 days of well completion, following instructions on ACO-1, side 1, and including copies of wireline logs.
4. Notify District office 48 hours prior to old well workover or re-entry.
5. Prior to plugging, prepare a plugging plan, then obtain agreement from the appropriate district office for an approved plugging plan.
6. Submit plugging report (CP-4) to K.C.C. after plugging is completed.
7. Obtain an approved injection docket number before disposing of salt water.
8. Notify K.C.C. within 10 days when injection commences or terminates.
9. If an alternate 2 completion, cement in the production pipe from below any usable water to surface within 120 days of spud date.

State Corporation Commission of Kansas
Conservation Division
200 Colorado Derby Building
Wichita, Kansas 67202
(316) 263-3238