


STATE OF KANSAS
STATE CORPORATION COMMISSION

WELL PLUGGING RECORD

Give All Information Completely
Make Required Affidavit
Mail or Deliver Report to
Conservation Division
State Corporation Comm.
245 North Water
Wichita, KS 67202

Ellis County. Sec. 11 Twp. 13 Rge. 18 W
Location as "NE/CNW $\frac{1}{4}$ SW $\frac{1}{4}$ " or footage from lines SESESE
330 FSL 330 FEL

Lease Owner Dreiling Resources 1983 Joint Venture
Lease Name Dreiling "F" Well No. 2
Office Address P. O. Box 278 Victoria, KS 67671
Character of Well (Completed as Oil, Gas or Dry Hole) _____

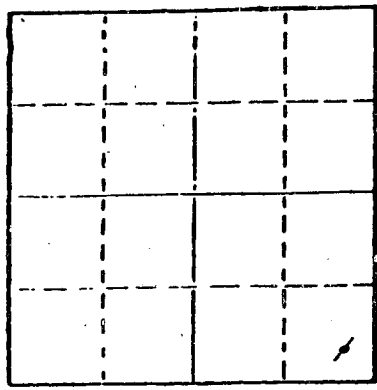

Locate well correctly on above
Section Plot

Oil
Date Well completed 7-20-83 19
Application for plugging filed 12-6-83 19
Application for plugging approved 12-9-83 19
Plugging commenced 12-14-83 19
Plugging completed 12-14-83 19
Reason for abandonment of well or producing formation _____

Oil Depleted
If a producing well is abandoned, date of last production
September 30, 1983 19

Was permission obtained from the Conservation Division or
its agents before plugging was commenced? Yes

Name of Conservation Agent who supervised plugging of this well Gib Scheck
Producing formation Lansing K.C. Depth to top 3440 Bottom 3685 Total Depth of Well 3699
Show depth and thickness of all water, oil and gas formations.

\$ 120.22

OIL, GAS OR WATER RECORDS

CASING RECORD

FORMATION	CONTENT	FROM	TO	SIZE	PUT IN	PULLED OUT
				8 5/8"	167	-0-
				4 1/2"	3738	-0-

Describe in detail the manner in which the well was plugged, indicating where the mud fluid was placed and the method or methods used in introducing it into the hold. If cement or other plugs were used, state the character of same and depth placed, from _____ feet to _____ feet for each plug set.

Well plugged in accordance with plugging orders; as follows:

25 sacks cement, 4 sks. hulls, 10 sks. gel, 70 sks cement, 5 sks. gel,

1 sk. Hulls & release plug, 70 sks. cement (used 60 sks. here). Shut off

at 1700 PSI. Total order - 165 sks. 50-50 poz., 4% gel, 3% cal. cl.

(If additional description is necessary, use BACK of this sheet)

Name of Plugging Contractor _____

STATE OF Kansas COUNTY OF Ellis, ss.
Alfred J. Dreiling (employee of owner) or (owner or operator)
of the above-described well, being first duly sworn on oath, says: That I have knowledge of the facts, statements, and matters herein contained and the log of the above-described well as filed and that the same are true and correct. So help me God.

(Signature) [Signature]
P. O. Box 278 Victoria, KS 67671
(Address)

SUBSCRIBED AND SWORN TO before me this 14th day of December, 1983

PAUL GROSS
STATE NOTARY PUBLIC
Ellis County, Kansas
My Appt. Expires April 7, 1984

My commission expires _____

[Signature]
Notary Public.

RECEIVED
STATE CORPORATION COMMISSION

DEC 15 1983
12-15-83
CONSERVATION DIVISION
Wichita, Kansas