


STATE OF KANSAS  
STATE CORPORATION COMMISSION

WELL PLUGGING RECORD

Give All Information Completely  
Make Required Affidavit  
Mail or Deliver Report to  
Conservation Division  
State Corporation Comm.  
245 North Water  
Wichita, KS 67202

Ellis County. Sec. 13 Twp. 13 Rge. 18 E/W  
Location as "NE/CNW $\frac{1}{4}$ SW $\frac{1}{4}$ " or footage from lines  
SW/4

Lease Owner Dreiling Resources, Inc.  
Lease Name Polifka B Well No. 2  
Office Address P. O. Box 278, Victoria, Kansas 67671  
Character of Well (Completed as Oil, Gas or Dry Hole) Dry Hole

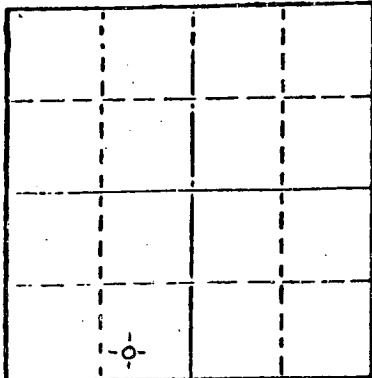

Locate well correctly on above  
Section Plat

Date Well completed 6-6 19 83  
Application for plugging filed 6-6 19 83  
Application for plugging approved 6-6 19 83  
Plugging commenced 6-6 19 83  
Plugging completed 6-6 19 83  
Reason for abandonment of well or producing formation \_\_\_\_\_

If a producing well is abandoned, date of last production  
19 \_\_\_\_\_

Was permission obtained from the Conservation Division or  
its agents before plugging was commenced? Yes

Name of Conservation Agent who supervised plugging of this well Marion Schmidt  
Producing formation \_\_\_\_\_ Depth to top \_\_\_\_\_ Bottom \_\_\_\_\_ Total Depth of Well 3750'  
Show depth and thickness of all water, oil and gas formations.

OIL, GAS OR WATER RECORDS

CASING RECORD

FORMATION	CONTENT	FROM	TO	SIZE	PUT IN	PULLED OUT
				8 5/8"	166'	-0-

Describe in detail the manner in which the well was plugged, indicating where the mud fluid was placed and the method or methods used in introducing it into the hold. If cement or other plugs were used, state the character of same and depth placed, from \_\_\_\_\_ feet to \_\_\_\_\_ feet for each plug set.

- 1st plug was set at 1410' with 20 sacks cement
- 2nd plug was set at 780' with 80 sacks cement
- 3rd plug was set at 240' with 40 sacks cement
- 4th plug was set at 40' with 10 sacks cement

(If additional description is necessary, use BACK of this sheet)

Name of Plugging Contractor \_\_\_\_\_

STATE OF KANSAS COUNTY OF ELLIS, ss.  
ALFRED J. DREILING (employee of owner) or (owner or operator)  
of the above-described well, being first duly sworn on oath, says: That I have knowledge of the facts, statements, and matters herein contained and the log of the above-described well as filed and that the same are true and correct. So help me God.

(Signature)

P.O. Box 278 Victoria, Kansas 67671  
(Address)

SUBSCRIBED AND SWORN TO before me this 20<sup>th</sup> day of July, 1983

PAUL GROSS  
STATE NOTARY PUBLIC  
Ellis County, Kansas  
My Appt. Expires April 7, 1984

Paul Gross  
Notary Public.

My commission expires