


STATE OF KANSAS
STATE CORPORATION COMMISSION
Give All Information Completely
Make Required Affidavit
Mail or Deliver Report to:
Conservation Division
State Corporation Commission
211 No. Broadway
Wichita, Kansas

WELL PLUGGING RECORD

Ellis County. Sec. 13 Twp. 13S Rge. 18 (E) (W) X
Location as "NE/CNW%SW%" or footage from lines: NE SW SW
Lease Owner Chief Drilling Company, Inc.
Lease Name Polifka Well No. 1
Office Address P. O. Box 797 Great Bend, Kansas
Character of Well (completed as Oil, Gas or Dry Hole) Oil
Date well completed _____ 19____
Application for plugging filed 4-26-66 19____
Application for plugging approved 4-27-66 19____
Plugging commenced 5-3-66 19____
Plugging completed 5-7-66 19____
Reason for abandonment of well or producing formation _____

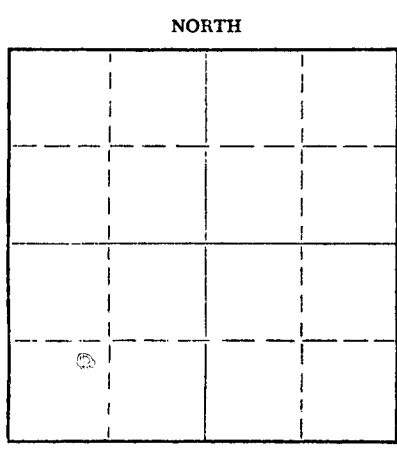

Locate well correctly on above Section Plat

If a producing well is abandoned, date of last production _____ 19____
Was permission obtained from the Conservation Division or its agents before plugging was commenced? Yes

Name of Conservation Agent who supervised plugging of this well Leo F. Massey
Producing formation _____ Depth to top _____ Bottom _____ Total Depth of Well 3796 Feet
Show depth and thickness of all water, oil and gas formations.

OIL, GAS OR WATER RECORDS

CASING RECORD

FORMATION	CONTENT	FROM	TO	SIZE	PUT IN	PULLED OUT
				8 5/8	205	None
				5 1/2		2075

Describe in detail the manner in which the well was plugged, indicating where the mud fluid was placed and the method or methods used in introducing it into the hole. If cement or other plugs were used, state the character of same and depth placed, from _____ feet to _____ feet for each plug set.

Moved in. Rigged up. Cleaned out cellar.
Working pipe. Shot pipe at 3000' - 2710' - 2503' - 2375' and 2278'.
Plugged off bottom with sand and 3 sacks of cement.
Pulled pipe.
Welded 8 5/8 collar on surface casing. Squeezed well with 100 sacks of cement, and 20 sacks of mud. Well completed.

RECEIVED
MAY 20 1966

(If additional description is necessary, use BACK of this sheet)
Name of Plugging Contractor Forbes Casing Pulling Company, Inc.
Address P. O. Box 221 Great Bend, Kansas

STATE OF Kansas, COUNTY OF Barton, ss. J. O. Forbes (employee of owner) or (owner or operator) of the above-described

well, being first duly sworn on oath, says: That I have knowledge of the facts, statements, and matters herein contained and the log of the above-described well as filed and that the same are true and correct. So help me God.

(Signature) J. O. Forbes
P. O. Box 221 Great Bend, Kansas
(Address)

SUBSCRIBED AND SWORN TO before me this 18 day of May, 1966

My commission expires May 27, 1969 Notary Public.

WELL LOG

15051-01524-00-00

RECEIVED
STATE CORPORATION COMMISSION

APR 27 1966

Chief Drilling Co., Inc.
Box 797
Great Bend, Kansas

POLIFKA #1
NE SW SW Sec. 13-13S-18W
Ellis County, Kansas

Contractor: Chief Drilling Co., Inc.

Commenced: 6/1/64
Completed: 6/10/64

Casing Record: 8-5/8" @ 205' w/150 sacks Sunset cement & 2 sacks Gel.
5-1/2" @ 3794' w/125 sacks cement

<u>FORMATION</u>	<u>FROM</u>	<u>TO</u>	<u>ELEVATION</u>	
Surface Sand & Gravel	0	90	2162 Gr.	
Post Rock & Shale	90	205	2164 D.F.	
Shale & Sand	205	910	2167 K.B.	
Sand	910	1070		
Shale	1070	1180		
Shale & Red Bed	1180	1400		
Anhydrite	1400	1440		
Shale & Shells	1440	2050		
Shale & Lime	2050	2440		
Lime	2440	2585		
Lime & Shale	2585	3152		
Lime	3152	3415		
Shale & Lime	3415	3463		
Lime	3463	3689		
Lime & Shale	3689	3713		
Cherty Conglomerate	3713	3795		
Total Depth	3795			

<u>FORMATION TOPS</u>	<u>Sample</u>	
Anhydrite	1400	
Topeka	3152	3157 - 990
Neeshner	3415	3418 - 1251
Toronto	3436	3440 - 1273
Lansing	3463	3465 - 1298
Base Kansas City	3689	3691 - 1524
Cherty Conglomerate	3713	3716 - 1549
Total Depth	3795	3796 - 1629

STATE OF KANSAS, COUNTY OF BARTON) SS

I hereby certify that the above is a true and correct copy of the Driller's Log of the well drilled in the NE SW SW Sec. 13-13S-18W, Ellis County, Kansas, to the best of my knowledge and belief.

CHIEF DRILLING CO., INC.

V. Richard Hoover
V. Richard Hoover, President

Subscribed and sworn to before me this 11th day of June, 1964.

Carmen R. Cook
Carmen R. Cook, Notary Public

My commission expires: Jan. 26, 1967

RECEIVED
STATE CORPORATION COMMISSION

APR 27 1966

GENERAL INVESTIGATION DIVISION
Wichita, Kansas