


STATE OF KANSAS
STATE CORPORATION COMMISSION

Form CP-4

Give All Information Completely
Make Required Affidavit
Mail or Deliver Report to:
Conservation Division
State Corporation Commission
211 No. Broadway
Wichita, Kansas

WELL PLUGGING RECORD

T - 11S NORTH R - 17W

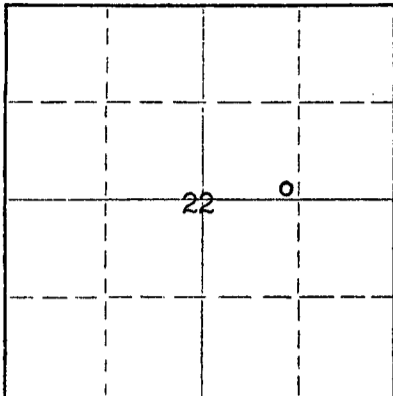

Locate well correctly on above
Section Plat

Ellis County. Sec. 22 Twp. 11 Rge. 17 (E) W (W)
Location as "NE/CNW/SW" or footage from lines SE SW NE
Lease Owner Frank J. Black
Lease Name J. Johansen Well No. 16
Office Address McPherson, Kansas
Character of Well (completed as Oil, Gas or Dry Hole) Oil
Date well completed 8-17-38 19
Application for plugging filed 3-2-66 19
Application for plugging approved 3-3-66 19
Plugging commenced 3-18-66 19
Plugging completed 3-26-66 19
Reason for abandonment of well or producing formation Depleted.

If a producing well is abandoned, date of last production 19
Was permission obtained from the Conservation Division or its agents before plugging was commenced? yes

Name of Conservation Agent who supervised plugging of this well Massey
Producing formation _____ Depth to top _____ Bottom _____ Total Depth of Well 3399 Feet
Show depth and thickness of all water, oil and gas formations.

OIL, GAS OR WATER RECORDS

CASING RECORD

FORMATION	CONTENT	FROM	TO	SIZE	PUT IN	PULLED OUT
				16"	60'	None
				10-3/4"	1125'	None
				7"	3393'	2409'

Describe in detail the manner in which the well was plugged, indicating where the mud fluid was placed and the method or methods used in introducing it into the hole. If cement or other plugs were used, state the character of same and depth placed, from _____ feet to _____ feet for each plug set.

Checked hole to 3399', sanded to 3375' and dumped 5 sacks of cement @ 3375' with dump bailer. Pulled 7" casing, mudded hole to 480', set rock bridge to 470' and pumped 40 sacks of cement. Pumped 10 sacks of gel mud to 40', set rock bridge to 30' and ran 15 sacks of cement to base of cellar.

RECEIVED
APR 12 1966

PLUGGING COMPLETE.

APR 12 1966
04-12-66

(If additional description is necessary, use BACK of this sheet)
Name of Plugging Contractor KNIGHT CASING PULLING COMPANY License #436
Address CHASE, KANSAS

STATE OF KANSAS, COUNTY OF RICE, ss.
Noel J. Knight (employee of owner) or (owner) of the above-described well, being first duly sworn on oath, says: That I have knowledge of the facts, statements, and matters herein contained and the log of the above-described well as filed and that the same are true and correct. So help me God.

(Signature) Noel J. Knight
Chase, Kansas
(Address)

SUBSCRIBED AND SWORN TO before me this 29th day of March, 19 66

My commission expires May 20, 1968

Milton J. Volin
Notary Public.

WELL LOG BUREAU - KANSAS GEOLOGICAL SOCIETY.
412 Union National Bk Bldg., Wichita, Kansas.

15-051-05828-0000

MAGNOLIA PETRO. CO.
J. Johnson No. 16.

SEC. 22 T. 11 R. 17
SE SW NE

Total Depth. 3399'
Comm. 7-24-38 Comp. 8-17-38
Shot or Treated.
Contractor.
Issued. 9-17-38

County. Ellis



CASINO:
16 " 500
10 3/4 " 1125'
7 " 3393'

Elevation.

Production. Pot. 2306 B.

Figures Indicate Bottom of Formations.

shale & sand	60
shale & shells	225
shale & sand	375
shale & shells	495
sand	580
shale & lime	685
sand	765
shale & shells	1070
red rock	1105
Top Anhydrite 1105	
anhydrite	1145
red rock	1380
red rock & sand	1470
salt	1670
shale & lime	1900
lime	2000
sand & shale	2060
lime	2392
shale & shells	2420
shale & lime	2485
lime	2529
shale & shells	2610
lime	2787
shale	2825
lime	3100
red rock	3116
sh oil 3210-20	
lime	3370
Top Simpson 3370	
Simpson fm.	3393
Top Arbuckle 3393	
Arbuckle lime	3395
cored 3388-95 6 1/2' rec	
Standardized	
Arbuckle lime	SLM3399
Total Depth,	

Well Swabbed 60 BPH for 3 Hrs to btm at 3395
Swabbed 105 BPH for 3 Hrs 1600' from btm
at 3399

RECEIVED
STATE CORPORATION COMMISSION

APR 12 1966

Wichita, Kansas