


WELL PLUGGING RECORD

Give All Information Completely  
Make Required Affidavit  
Mail or Deliver Report to:  
Conservation Division  
State Corporation Commission  
800 Bittling Building  
Wichita, Kansas

Ellis County. Sec. 22 Twp. 11N Rge. 17 (E) (W)

Location as "NE/CNW $\frac{1}{4}$ SW $\frac{1}{4}$ " or footage from lines SW NW NW  
Lease Owner The British-American Oil Producing Company  
Lease Name Bemis Well No. SWD #1  
Office Address 910 South Boston, Tulsa, Oklahoma  
Character of Well (completed as Oil, Gas or Dry Hole) Salt Water Disposal  
Date well completed 11-26 19 38  
Application for plugging filed 2-15- 19 52  
Application for plugging approved 2-18 19 52  
Plugging commenced 5-8 19 52  
Plugging completed 5-27 19 52  
Reason for abandonment of well or producing formation

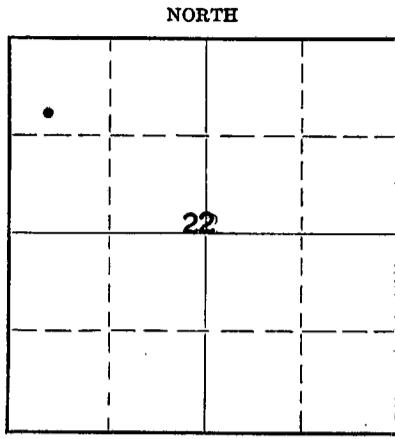

Locate well correctly on above Section Plat

If a producing well is abandoned, date of last production - 19  
Was permission obtained from the Conservation Division or its agents before plugging was commenced? Yes


Name of Conservation Agent who supervised plugging of this well Eldon Petty  
Producing formation - Depth to top - Bottom - Total Depth of Well 858 Feet  
Show depth and thickness of all water, oil and gas formations.

OIL, GAS OR WATER RECORDS CASING RECORD

| Formation | Content | From | To | Size | Put In | Pulled Out |
|-----------|---------|------|----|------|--------|------------|
|           |         |      |    | 13"  | 56'    | None       |
|           |         |      |    | 7"   | 698'   | None       |
|           |         |      |    |      |        |            |
|           |         |      |    |      |        |            |
Describe in detail the manner in which the well was plugged, indicating where the mud fluid was placed and the method or methods used in introducing it into the hole. If cement or other plugs were used, state the character of same and depth placed, from feet to feet for each plug set.

Casing set at 698'. Measured cavings in hole with steel line at 694' which is 4' in pipe. Mixed 150 sacks cement; ran 7" on top of regular top plug; cement went in under vacuum. Checked top of cement with steel line at 208'. Mudded hole to 40'. Ran 8 sacks cement which filled up to 5'. Cut off and covered pipe.


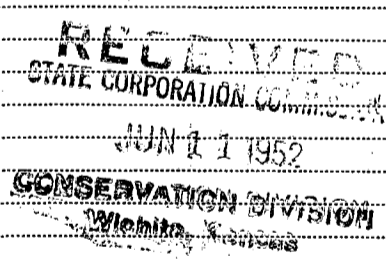


(If additional description is necessary, use BACK of this sheet)  
Correspondence regarding this well should be addressed to Fred Norris, District Superintendent  
Address P. O. Box 3187, Oklahoma City, Oklahoma

STATE OF Oklahoma, COUNTY OF Oklahoma, ss.  
Fred Norris (employee of owner) or (owner or operator) of the above-described well,  
being first duly sworn on oath, says: That I have knowledge of the facts, statements, and matters herein contained and the log of the above-described well as filed and that the same are true and correct. So help me God.

(Signature) Fred Norris Dist. Supt.  
Box 3187, Oklahoma City, Oklahoma (Address)

SUBSCRIBED AND SWORN to before me this 10th day of June 19 52  
My commission expires 12-18-54

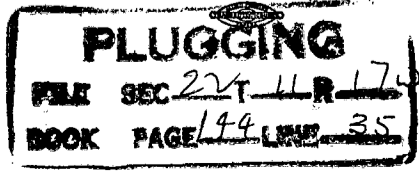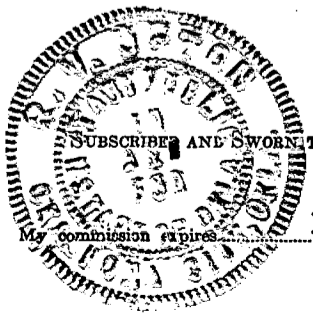

Notary Public.

THE BRITISH-AMERICAN OIL PRODUCING COMPANY  
BEMIS SWD NO. 1

LOCATION: 330' From West Line and 880' From North Line of Section  
22, Township 11 North, Range 17 West, Ellis County,  
Kansas

13" OD 54# SS Casing set at 56' and cemented with  
25 sacks cement.

7" OD 24# and 26# SS Casing set at 698' and cemented  
with 375 sacks cement.

Drilling Commenced  
Drilling Completed

11-1-38  
11-26-38

| <u>DEPTH</u> |     | <u>FORMATION</u>            |
|--------------|-----|-----------------------------|
| 0'           | 44' | Clay and Shale              |
| 44           | 120 | Blue Shale                  |
| 120          | 395 | Shale and Sand              |
| 395          | 460 | Redbeds and Shale           |
| 460          | 545 | Redbeds, Lime, and Shale    |
| 545          | 570 | Sand and Iron               |
| 570          | 620 | Sand, Lime and Iron         |
| 620          | 664 | Shale, Lime and Sand        |
| 664          | 697 | Sand, Shale, Lime, and Iron |
| 697          | 710 | White Sand                  |
| 710          | 848 | Sand                        |
| 848          | 858 | Sand and Shale              |

T.D.....858'

**PLUGGING**  
FILE SEC 22T 11 R 17W  

RECORDED  
SERIALIZED  
FEB 16 1939  
