

STATE OF KANSAS
STATE CORPORATION COMMISSION


Give All Information Completely
Make Required Affidavit
Mail or Deliver Report to:
Conservation Division
State Corporation Commission
212 No. Market
Wichita, Kansas

WELL PLUGGING RECORD

Ellis County, Sec. 22 Twp. 11 Rge. (E) 17 (W)

Location as "NE/CNW/SW" or footage from lines EN/4 NE/4 NW/4
Lease Owner Ormand Industries
Lease Name Bemis "A" Well No. 5
Office Address 2118 Adolphus Tower, Dallas, Texas
Character of Well (completed as Oil, Gas or Dry Hole) oil
Date well completed August 27 19 37
Application for plugging filed 19
Application for plugging approved 19
Plugging commenced 4/29/69 19
Plugging completed 5/5/69 19
Reason for abandonment of well or producing formation depleted.

NORTH

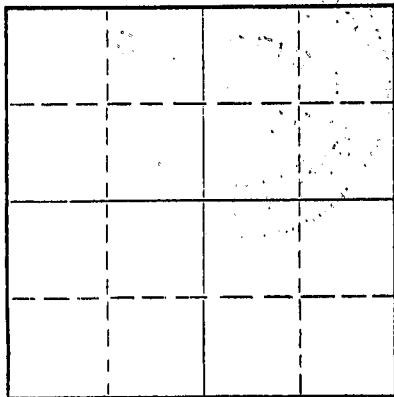

Locate well correctly on above Section Plat

If a producing well is abandoned, date of last production 19
Was permission obtained from the Conservation Division or its agents before plugging was commenced? yes

Name of Conservation Agent who supervised plugging of this well Massey
Producing formation Arbuckle Depth to top 3430 Bottom 3439 Total Depth of Well 3439 Feet
Show depth and thickness of all water, oil and gas formations.

OIL, GAS OR WATER RECORDS

CASING RECORD

FORMATION	CONTENT	FROM	TO	SIZE	PUT IN	PULLED OUT
Arbuckle	oil	3430	3439	15 1/2"	30'	none
				10-3/4"	1137'	none
				7"	3430'	1617'
				4 1/2" liner		

Describe in detail the manner in which the well was plugged, indicating where the mud fluid was placed and the method or methods used in introducing it into the hole. If cement or other plugs were used, state the character of same and depth placed, from _____ feet to _____ feet for each plug set.

Checked bottom, ran sand to 3400', dumped 4 sacks of cement. Loaded hole, shot pipe at 1896, 1805, 1714, 1620', pulled 52 joints of 7". Allied plugged well with 160 sacks of cement, 30 sacks gel and 5 sacks hulls.

PLUGGING COMPLETE.

RECEIVED
STATE CORPORATION COMMISSION
MAY 20 1969
CONSERVATION DIVISION
Wichita, Kansas

(If additional description is necessary, use BACK of this sheet)
KNIGHT CASING PULLING CO., INC.


Name of Plugging Contractor KNIGHT CASING PULLING CO., INC.
Address CHASE, KANSAS

STATE OF KANSAS COUNTY OF RICE, ss.
NOEL J. KNIGHT

(employee of owner) or (owner or operator) of the above-described well, being first duly sworn on oath, says: That I have knowledge of the facts, statements, and matters herein contained and the log of the above-described well as filed and that the same are true and correct. So help me God.

(Signature) Noel Knight
CHASE, KANSAS
(Address)

SUBSCRIBED AND SWORN to before me this 6th day of May, 19 69

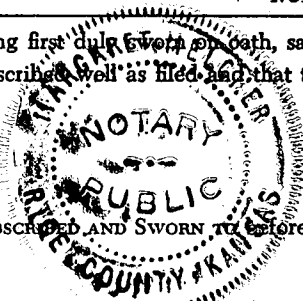

My commission expires 2/15/71

Margaret Melches
Notary Public.

BEMIS A - 5

NE NE NW 22-11-17W
Ellis County, Kansas

Shale	0 - 235
Shale & shells	235 - 400
Shale, shells & iron pyrite	400 - 661
Shale & shells	661 - 868
Red bed	868 - 1000
Red bed & iron pyrite	1000 - 1130
Anhydrite	1130 - 1180
Shale	1180 - 1430
Shale & salt	1430 - 1550
Salt	1550 - 1684
Lime	1684 - 1815
Shale & lime	1815 - 2037
Lime	2037 - 2088
Lime & shale	2088 - 2125
Lime	2125 - 2280
Lime & shale	2280 - 2331
Lime	2331 - 2488
Lime & shale	2488 - 2875
Lime	2875 - 3400
Lime & shale	3400 - 3403
Shale	3403 - 3431
Siliceous lime	3430 - 3439

RECEIVED
STATE CORPORATION COMMISSION
FEB 18 1969
CONSERVATION DIVISION
Wichita, Kansas