

15-051-30273-00-00
WELL PLUGGING RECORD

Give All Information Completely
Make Required Affidavit
Mail or Deliver Report to:
Conservation Division
State Corporation Commission
211 No. Broadway
Wichita, Kansas

Ellis County. Sec. 12 Twp. 13 Rge. 19 (E) W (W)

Location as "NE/CNW/SW" or footage from lines SW SE SW

Lease Owner S. and C. Drilling, Inc.

Lease Name Leo Walter Well No. 1

Office Address Box 271 Hays, Kansas

Character of Well (completed as Oil, Gas or Dry Hole) D&A

Date well completed Mar. 20 19 66

Application for plugging filed " " 19 66

Application for plugging approved " " 19 66


Plugging commenced 10 A.M. Mar. 20 19 66

Plugging completed 5 P.M. Mar. 20 19 66

Reason for abandonment of well or producing formation _____

If a producing well is abandoned, date of last production _____ 19 _____

Was permission obtained from the Conservation Division or its agents before plugging was commenced? Yes

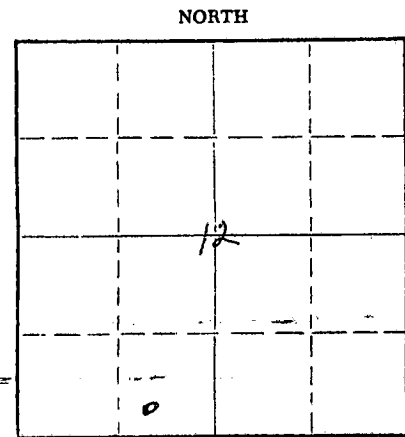

Locate well correctly on above Section Plat

Name of Conservation Agent who supervised plugging of this well Leo Massey

Producing formation _____ Depth to top _____ Bottom _____ Total Depth of Well 3780 Feet

Show depth and thickness of all water, oil and gas formations.

OIL, GAS OR WATER RECORDS

CASING RECORD

FORMATION	CONTENT	FROM	TO	SIZE	PUT IN	PULLED OUT

Describe in detail the manner in which the well was plugged, indicating where the mud fluid was placed and the method or methods used in introducing it into the hole. If cement or other plugs were used, state the character of same and depth placed, from _____ feet to _____ feet for each plug-set.

Plugged w/plug @ 400' w/20 sks cement thru drill pipe. Plug @ 210' w/20 sks cement & 1/2 sk hulls. Plug @ 40' w/10 sks cement + 2 sks in rat hole.

RECEIVED
STATE CORPORATION COMMISSION
APR 4 1966

(If additional description is necessary, use BACK of this sheet)

Name of Plugging Contractor S. and C. Drilling, Inc.

Address Box 271 Hays, Kansas

STATE OF Kansas, COUNTY OF Ellis, ss.

D. J. Sullivan (employee of owner) or (owner or operator) of the above-described well, being first duly sworn on oath, says: That I have knowledge of the facts, statements, and matters herein contained and the log of the above-described well as filed and that the same are true and correct. So help me God.

(Signature) D. J. Sullivan

Box 271 Hays, Kansas
(Address)

SUBSCRIBED AND SWORN to before me this 31 day of March 1966

4-28-66

Marlyn L. Stone
Notary Public.



C. R. CARLSON
President

D. J. SULLIVAN
Exec. Vice President

S. and C. Drilling, Inc.

Phone MA 4-4350 - Box 271
1309 Steven Drive

HAYS, KANSAS 67601

15-051-30273-00-00



CERTIFIED DRILLER'S LOG

COMPANY: S. and C. Drilling, Inc.

LEASE: Leo Walter

CONTRACTOR: S. and C. Drlg, Inc.

LOCATION: SW SE SW
12-13-19W
Ellis Co., Kans.

COMMENCED UNDER SURFACE: Mar. 11, 1966

COMPLETED: Mar. 20, 1966

ELEVATION: ~~2100~~ 2121' gr. level

POTENTIAL: D & A

FIGURES DENOTE BOTTOM OF FORMATION: K.B. Measurements
(Gr. level, plus 5')

<u>FORMATION</u>	<u>DEPTH</u>
Post Rock Sand	140
Shale	217 (Surface set 217')
Shale & Sand	850
Sand	1120
Shale w/sand	1433
Anhydrite	1479
Shale & shells	1715
Shale & lime	2172
Lime & Shale	2400
Lime w/shale streaks	2500
Lime & Shale	3058
Lime	3105
Lime & Shale	3215
Lime	3738
Cherty Conglomerate	3774
Conglomerate	3780 T.D.

RECEIVED
STATE CORPORATION COMMISSION
APR 4 1966
CONSERVATION DIVISION
Topeka, Kansas

I hereby certify that this is a true and correct copy of the driller's log to the best of my knowledge.

S. and C. Drilling, Inc.

By: D. J. Sullivan
D. J. Sullivan