

15-051-21760-000

STATE OF KANSAS  
STATE CORPORATION COMMISSION

WELL PLUGGING RECORD

Give All Information Completely  
Make Required Affidavit  
Mail or Deliver Report to  
Conservation Division  
State Corporation Comm.  
245 North Water  
Wichita, KS 67202

Ellis County, Sec. 17 Twp. 13 Rge. 19  W  
Location as "NE/CNW $\frac{1}{4}$ SW $\frac{1}{4}$ " or footage from lines

SE NE SW

Lease Owner Dreiling Oil, Inc.

Lease Name Bemis Well No. 1-17

Office Address 211 N. Broadway, Box 247, Wichita, KS 67202

Character of Well (Completed as Oil, Gas or Dry Hole)

Dry Hole

Date Well completed 9-6 1979

Application for plugging filed 9-6 1979

Application for plugging approved 9-6 1979

Plugging commenced 9-6 1979

Plugging completed 9-6 1979

Reason for abandonment of well or producing formation

Dry Hole

If a producing well is abandoned, date of last production


19

Was permission obtained from the Conservation Division or its agents before plugging was commenced? yes

Name of Conservation Agent who supervised plugging of this well Gilbert Balthazor

Producing formation Depth to top Bottom Total Depth of Well 3,788'

Show depth and thickness of all water, oil and gas formations.

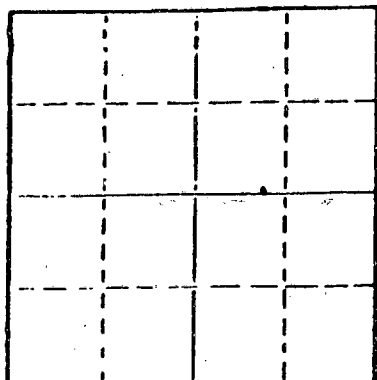

Locate well correctly on above Section Flat

OIL, GAS OR WATER RECORDS

CASING RECORD

FORMATION	CONTENT	FROM	TO	SIZE	PUT IN	PULLED OUT
Surface Pipe				8 5/8"	260'	0'

Describe in detail the manner in which the well was plugged, indicating where the mud fluid was placed and the method or methods used in introducing it into the hold. If cement or other plugs were used, state the character of same and depth placed, from \_\_\_\_\_ feet to \_\_\_\_\_ feet for each plug set.

1st plug was set @ 500' w/60 sacks

2nd plug was set @ 260' w/30 sacks

3rd plug was set @ 40' w/10 sacks

(If additional description is necessary, use BACK of this sheet)

Name of Plugging Contractor Dreiling Oil, Inc.

RECEIVED  
STATE CORPORATION COMMISSION  
SEP 12 1979  
WICHITA, KANSAS

STATE OF KANSAS COUNTY OF ELLIS

I, Joseph A. Hess, Sec. Treas. of Drlg. Contrc. (employee of owner) or (owner or operator)

of the above-described well, being first duly sworn on oath, says: That I have a knowledge of the facts, statements, and matters herein contained and the log of the above-described well as filed and that the same are true and correct. So help me God.

(Signature)

JOSEPH A. HESS, HAYS, KS 67601

(Address)

SUBSCRIBED AND SWORN TO before me this 11th day of September, 1979

Cecilia Basgall  
Cecilia Basgall Notary Public.

My commission expires November 17, 1980

CECILIA BASGALL  
NOTARY PUBLIC  
Ellis County, Kansas

# DREILING OIL, INC.

Victoria, Kansas 67671

## Graham-Michaelis Corp. WELL LOG

211 N. Broadway - Box 247

Company: Graham-Michaelis Corp. WELL LOG  
211 N. Broadway - Box 247  
Wichita, KS 67202

Sec. 17-13-~~Twp.~~ Rng.

Farm: Bemis No. 1-17 Location: SE NE SW

Total Depth: 3,788' County: Ellis

Comm.: 8-28-79 Comp.: 9-6-79 Elevation: 2070 K. B.

Contractor: Dreiling Oil, Inc. 2067 D. F.  
Rt. #1  
Victoria, KS 67671 2065 G. R.

Casing Record  
260' - 8 5/8"

Cement Record  
150 sacks cement

Production:  
D & A

### Figures Indicate Bottom of Formations


0'	80'	Top Soil & Sand
80'	264'	Blue Shale
264'	850'	Shale
850'	1090'	Sand
1090'	1398'	Shale
1398'	1440'	Anhydrite
1440'	2187'	Shale
2187'	2606'	Lime & Shale
2606'	3022'	Shale
3022'	3233'	Shale & Lime
3233'	3774'	Lime & arbuckle
3774'	3788'	Lime
3788'	T.D.	

STATE OF KANSAS)  
  )ss  
COUNTY OF ELLIS)

I, Joseph A. Hess, Secretary Treasurer of Dreiling Oil, Inc. upon oath states that the above and foregoing is a true and correct copy from the Daily Drilling Report from the Bemis 1-17.

  
JOSEPH A. HESS

Subscribed and sworn to before me this 11th day of September, 1980.

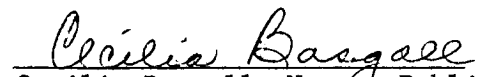  
Cecilia Basgall Notary Public

My appointment expires: November 17, 1980.

**CECILIA BASGALL**  
**NOTARY PUBLIC**  
**Ellis County, Kansas**

RECEIVED  
STATE DEPARTMENT COMMISSION  
SEP 12 1979  
CONSERVATION DIVISION  
Wichita, Kansas