


STATE OF KANSAS  
STATE CORPORATION COMMISSION

Give All Information Completely  
Make Required Affidavit  
Mail or Deliver Report to:  
Conservation Division  
State Corporation Commission  
800 Bitting Building  
Wichita, Kansas

15-051-00072-00-00  
WELL PLUGGING RECORD

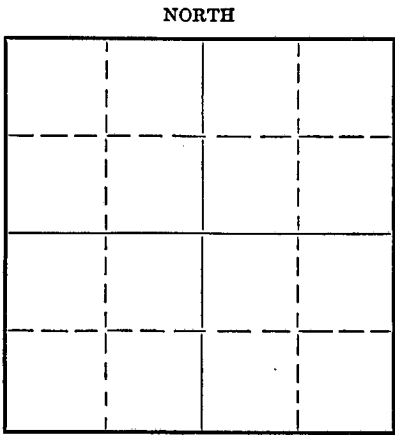

Locate well correctly on above Section Plat

Ellis County, Sec. 35 Twp. 13 Rge. 19 (E) West W  
Location as "NE/CNW $\frac{1}{4}$ /SW $\frac{1}{4}$ " or footage from lines NW NE Ne  
Lease Owner Don E. Pratt  
Lease Name Dinges Well No. 1  
Office Address Box 656, Hays, Kansas  
Character of Well (completed as Oil, Gas or Dry Hole) Dry Hole  
Date well completed Dec. 14, 1952 19  
Application for plugging filed Dec. 14, 1952 19  
Application for plugging approved Dec. 14, 1952 19  
Plugging commenced Dec. 14, 1952 19  
Plugging completed Dec. 14, 1952 19  
Reason for abandonment of well or producing formation Dry hole

If a producing well is abandoned, date of last production 19  
Was permission obtained from the Conservation Division or its agents before plugging was commenced? Yes

Name of Conservation Agent who supervised plugging of this well Eldon Petty  
Producing formation None Depth to top Bottom Total Depth of Well 3931 Feet  
Show depth and thickness of all water, oil and gas formations.

OIL, GAS OR WATER RECORDS

CASING RECORD

Formation	Content	From	To	Size	Put In	Pulled Out
Arbuckle Lime	Dry	Unknown	3931	8 5/8"	210	None

Describe in detail the manner in which the well was plugged, indicating where the mud fluid was placed and the method or methods used in introducing it into the hole. If cement or other plugs were used, state the character of same and depth placed, from feet to feet for each plug set.

Plug at 180' to 170' hulls, 14 sacks cement, mud to 40 feet, plug, cement to 6' below surface.

RECEIVED  
STATE CORPORATION COMMISSION  
JAN 12 1953 01-12-53  
CONSERVATION DIVISION  
Wichita, Kansas

(If additional description is necessary, use BACK of this sheet)

Correspondence regarding this well should be addressed to Don E. Pratt  
Address Box 656, Hays, Kansas

STATE OF Kansas, COUNTY OF Ellis, ss.  
Don E. Pratt (employee of owner) or (owner or operator) of the above-described well, being first duly sworn on oath, says: That I have knowledge of the facts, statements, and matters herein contained and the log of the above-described well as filed and that the same are true and correct. So help me God.


(Signature) *Don E. Pratt*  
Hays, Kansas (Address)

SUBSCRIBED AND SWORN to before me this 9th day of January, 1953

My commission expires October 1, 1955

23-5091-s 8-50-10M

PLUGGING  
FILE SEC 35 T 13 R 19  
BOOK PAGE 66 LINE 30

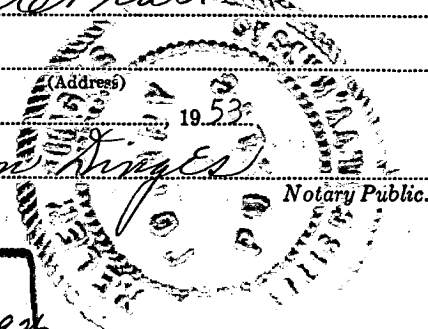

Dinges # 1 - NW NE NE/4 Section 35-13-19w Ellis County, Kansas  
 Company - Don Pratt  
 Contractor - Virginia Drlg Co Inc  
 Commenced - Nov. 23, 1952  
 Completed - Dec. 14, 1952  
 Total Depth - 3931  
 Elevation - 2176

15051-00072-00-00

8 5/8" set at 212' w/ 150 sz. cem.

FORMATION	DEPTH
Rock	0- 105
Shale	105- 885
Sand	885-1200
Shale?	1200-1228
Shale-shells	1228-1461
Anhydrite	1461-1485
Anhydrite & shale	1485-1535
Shale-shells	1535-1700
Salt-shale	1700-1790
Shale-shells	1790-2083
Lime-shale	2083-2195
Lime-shells	2195-2288
Lime-shells-shale	2288-2370
Lime shale	2370-2468
Lime-shells	2468-2550
Lime-shells-shale	2550-2617
Shale-shells	2617-2755
Lime-shells	2755-2840
Shale-lime	2840-3020
Lime shells	3020-3110
Shale-lime	3110-3367
Lime	3367-3445
Lime-shale	3445-3490
Lime	3490-3584
Lime shale	3584-3612
Lime	3612-3815
Lime-shale	3815-3853
Lime-cherty-	3853-3904
Lime	3904-3931 TD

TOPS:

- 3200-Topoka
- 3447-Marmaton
- 3462-Heebner
- 3464-Leavenworth
- 3483-Toronto
- 3510-Lansing
- 3810-Cherty-cong.
- 3834-Re-work Arb.
- 3848-Arbuckle

Dry hole

*Samuel J. Murphy*

Subscribed and sworn to before me, a Notary Public, this  
 23rd day of December, 1952.

*Mudie Watkins*  
 Notary Public

My commission expires: Feb. 5, 1953.

RECORDED  
 JAN 13 1953

**PLUGGING**  
 FILE SEC 364 13 1952  
 BOOK PAGE 66 LINE 32