


WELL PLUGGING RECORD

15-05100620-0000

ELLIS County. Sec. 33 Twp. 13 Rge. (E) 19 (W)

Location as "NE/CNW $\frac{1}{4}$ SW $\frac{1}{4}$ " or footage from lines SE SE NW
 Lease Owner BUFFALO OIL COMPANY AND R. W. RINE DRILLING COMPANY
 Lease Name BEMIS Well No. 1
 Office Address 320 CENTRAL BUILDING, WICHITA 2, KANSAS
 Character of Well (completed as Oil, Gas or Dry Hole) DRY HOLE
 Date well completed JULY 30, 19 51
 Application for plugging filed JULY 30, 19 51
 Application for plugging approved JULY 30, 19 51
 Plugging commenced JULY 30, 19 51
 Plugging completed JULY 30, 19 51
 Reason for abandonment of well or producing formation DRY

NORTH

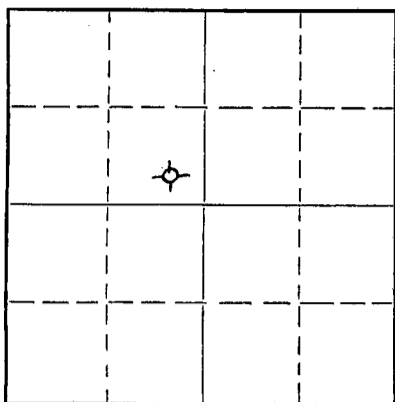

Locate well correctly on above Section Plat

If a producing well is abandoned, date of last production 19
 Was permission obtained from the Conservation Division or its agents before plugging was commenced? YES, IN FIELD

Name of Conservation Agent who supervised plugging of this well ELOON PETTY, HAYS, KANSAS
 Producing formation ARBUCKLE Depth to top 3935 RB Bottom 3976 RB Total Depth of Well 3976 RB Feet
 Show depth and thickness of all water, oil and gas formations.

OIL, GAS OR WATER RECORDS

CASING RECORD

Formation	Content	From	To	Size	Put In	Pulled Out
POST ROCK, CLAY & SHALE	WATER	0	214	8-5/8	214'	NONE
SHALE, SHELLS & LIME	WATER	214	3976	5-1/2	NONE	----

Describe in detail the manner in which the well was plugged, indicating where the mud fluid was placed and the method or methods used in introducing it into the hole. If cement or other plugs were used, state the character of same and depth placed, from _____ feet to _____ feet for each plug set.

SET PLUG AND FILLED HOLE W/ HEAVY MUD 3976 TO 200
 CEMENT - 15 SACKS 200 TO 152
 HEAVY MUD 152 TO 40
 CEMENT - 10 SACKS 40 TO 10
 SOIL 10 TO 0

RECEIVED
STATE CORPORATION COMMISSION
AUG 11 1951

(If additional description is necessary, use BACK of this sheet)
 Correspondence regarding this well should be addressed to R. W. RINE DRILLING COMPANY
 Address 320 CENTRAL BUILDING, WICHITA 2, KANSAS.

STATE OF KANSAS, COUNTY OF SEDGWICK, ss.
 Mr. R. M. GREEN (employee of owner) or ~~owner or operator~~ of the above-described well, being first duly sworn on oath, says: That I have knowledge of the facts, statements, and matters herein contained and the log of the above-described well as filed and that the same are true and correct. So help me God.
 R. W. RINE DRILLING COMPANY
 BY *R. M. Green*
 320 CENTRAL BUILDING, WICHITA 2, KANSAS
 (Address)

SUBSCRIBED AND SWORN TO before me this 9TH day of AUGUST, 19 51

Leona Peterson
Notary Public.



PLUGGING
FILE SEC-33-T-13-R-194
BOOK PAGE-99-LINE-40

ROCKET DRILLING COMPANY
352 NORTH BROADWAY
WICHITA 2, KANSAS

15-051-00620-00-00

R. W. RINE DRILLING COMPANY
 320 CENTRAL BUILDING
 WICHITA 2, KANSAS

BEMIS #1
 SE SE NW; 33-13-19W
 ELLIS COUNTY, KANSAS

ELEVATION: 2241 D.F. - 2243 R.B.
 SPUDDED: JULY 16, 1951
 ROTARY COMPLETED: JULY 30, 1951
 CABLE TOOLS COMPLETED:
 INITIAL PRODUCTION: D. & A.
 CONTRACTOR: ROCKET DRILLING COMPANY

CASING RECORD

214' 8-5/8" 24# SURFACE CASING, CEMENTED W/ 125 SACKS CEMENT.
 5-1/2" NONE

DRILLERS LOG


POST ROCK	0 TO 50	LIME & SHALE	2495 TO 2770
CLAY & POST ROCK	160	LIME	3030
SHALE & SHELLS	214	LIME & SHALE	3130
SHALE	680	SHALE	3140
SAND & SHALE	1390	LIME	3190
SHALE & SHELLS	1585	LIME & SHALE	3238
SHALE	1810	LIME	3866
SHALE & SHELLS	1980	LIME & CONGLOMERATE	3916
SHALE & LIME	2160	LIME	3976 T.D.
LIME	2495	3976 T.D. = 3974 D.F.	

STATE OF KANSAS) SS:
 SEDGWICK COUNTY)

I HEREBY CERTIFY THAT TO THE BEST OF MY KNOWLEDGE AND BELIEF,
 THE FOREGOING LOG IS TRUE AND CORRECT.

ROCKET DRILLING COMPANY

BY L. L. Cotter

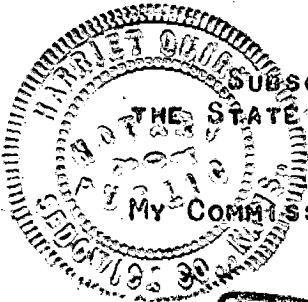

SUBSCRIBED AND SWORN TO BEFORE ME, A NOTARY PUBLIC, IN AND FOR
 THE STATE AND COUNTY AFORESAID THIS _____ DAY OF AUGUST, 1951.

RECEIVED
 STATE CORRELATION DIVISION
 NOTARY PUBLIC
 AUG 11 1951

CONSERVATION DIVISION
 Wichita, Kansas

PLUGGING
 FILE SEC 33-13-19W
 BOOK PAGE 99 LINE 40