

STATE OF KANSAS
 STATE CORPORATION COMMISSION
 200 Colorado Derby Bldg.
 Wichita, Kansas 67202


15-007-21532-0000
 Form CP-4
 Rev. 12-15-80

WELL PLUGGING RECORD

Give All Information Completely
 Make Required Affidavit

COUNTY BARBER SEC. 3 TWP. 35S RGE. 10 W/W
 Location as in quarters or footage from lines:

660' from South Line and 760' from West Line of the SW/4

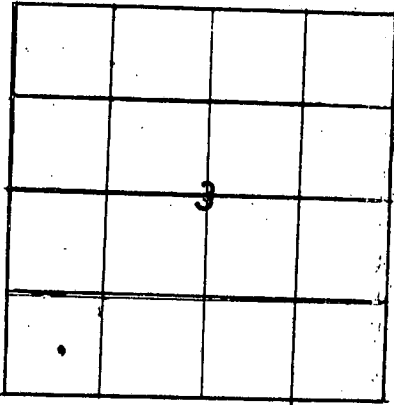

Locate Well
 correctly on above
 Section Platt.

Lease Owner THE PICKENS COMPANY, INC.

Lease Name H. SCHUPBACH Well No. 1

Office Address 800 Preston Bank Building

Character of Well (Completed as Oil, Gas or Dry Hole): Dry Hole

Date Well Completed 12/4/82

Application for plugging filed 12/13/82

Plugging commenced 12/4/82

Plugging completed 12/4/82

Reason for abandonment of well or producing formation

Dry Hole

Was permission obtained from the Conservation Division or it's
 Agent's before plugging was commenced? Yes

Name of Conservation Agent who supervised plugging of this well J. H. Metz, Dodge City

Producing formation ----- Depth to top ----- bottom ----- T.D. 5330'

Show depth and thickness of all water, oil and gas formations.

OIL, GAS OR WATER RECORDS

Casing Record

Formation	Content	From	To	Size	Put in	Pulled Out.
SEE ATTACHED DST INFORMATION				8-5/8"	261'	None

Describe in detail the manner in which the well was plugged, indicating where the mud fluid was placed and the method or methods used in introducing it into the hold. If cement or other plugs were used, state the character of same and depth placed, from feet to feet for each plug set.

- Plug No. 1 set with 70 sx. 50/50 Poz cement from 750' to 610'
- Plug No. 2 set with 40 sx. 50/50 Poz cement from 260' to 180'
- Plug No. 3 set with 10 sx. 50/50 Poz cement from 40' to surface.

(If additional description is necessary, use BACK of this sheet)

Name of Plugging Contractor Allied Cementing Company, Inc.


STATE OF TEXAS COUNTY OF DALLAS, ss.

Kathleen A. Yant (~~employee of owner~~ or ~~owner~~ or ~~operator~~) of the above-described well, being first duly sworn on oath, says: That I have knowledge of the facts, statements, and matters herein contained and the log of the above-described well as filed and that the same are true and correct. So help me God.

(Signature) Kathleen A. Yant
800 Preston Bank Building
 Dallas, (Address) Texas 75225

SUBSCRIBED AND SWORN TO before me this 23 day of December, 1982

My Commission expires: August 6, 1985

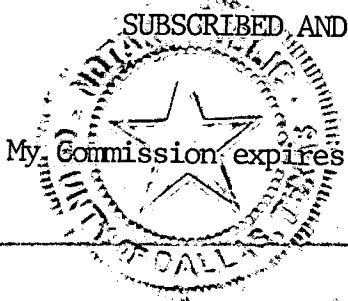

Cheryl M. [Signature]
 Notary Public.

RECEIVED
 STATE CORPORATION COMMISSION
 DEC 27 1982

CONSERVATION DIVISION
 Wichita, Kansas