


STATE OF KANSAS
STATE CORPORATION COMMISSION

WELL PLUGGING RECORD

Give All Information Completely
Make Required Affidavit
Mail or Deliver Report to
Conservation Division
State Corporation Comm.
245 North Water
Wichita, KS 67202

Barber County, Sec. 10 Twp. 35 Rge. 10 E/W
Location as "NE/CNW $\frac{1}{4}$ SW $\frac{1}{4}$ " or footage from lines
C SE $\frac{1}{4}$ NE $\frac{1}{4}$

Lease Owner Wild Boys Land Cattle and Oil Co., Inc.
Lease Name Schrack Well No. 1
Office Address Suite 3A 807 N. Waco, Wichita, KS 67202
Character of Well (Completed as Oil, Gas or Dry Hole)

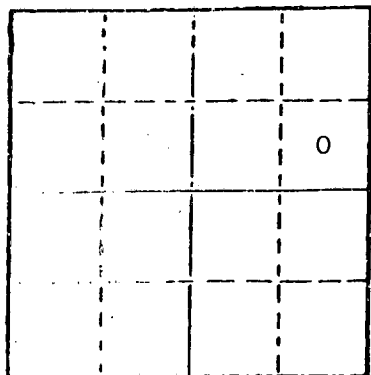

Locate well correctly on above
Section Plat

Dry Hole
Date Well completed 1-13-1981 19
Application for plugging filed 1-13-1981 19
Application for plugging approved 1-13-1981 19
Plugging commenced 11:00 p.m. 1-13-1981 19
Plugging completed 2:00 a.m. 1-14-1981 19
Reason for abandonment of well or producing formation

D & A
If a producing well is abandoned, date of last production
X 19X

Was permission obtained from the Conservation Division or
its agents before plugging was commenced? Yes

Name of Conservation Agent who supervised plugging of this well Gilbert Toman
Producing formation None Depth to top X Bottom X Total Depth of Well 5375
Show depth and thickness of all water, oil and gas formations.

OIL, GAS OR WATER RECORDS

CASING RECORD

| FORMATION | CONTENT | FROM | TO | SIZE | PUT IN | PULLED OUT |
|-----------|---------|------|----|------|--------|------------|
| | | | | | | |
| | | | | | | |
| | | | | | | |
| | | | | | | |

Describe in detail the manner in which the well was plugged, indicating where the mud fluid
was placed and the method or methods used in introducing it into the hold. If cement or other
plugs were used, state the character of same and depth placed, from _____ feet to
_____ feet for each plug set.

Used 90 sks. 50/50 pozmix with 4% Gel
Run Hole full of Mud Spotted 70 sks at 400' through the drill pipe
Set a wooden bridge plug with one half sack of Hulls at 40'
and spotted 10 sks cement through the drill pipe
Put 5 sks cement in Rathole
Put 5 sks cement in Mousehole

Cementing was done by Sun Cementing Co. Great Bend, KS

JAN 21 1981
01-21-81
RCW

(If additional description is necessary, use BACK of this sheet)

Name of Plugging Contractor Trans-Pac Drilling Inc.

CONSERVATION DIVISION
Wichita, Kansas

STATE OF Kansas COUNTY OF Sedgwick, ss.
Jack Kaiser (employee of owner) or (owner or operator)
of the above-described well, being first duly sworn on oath, says: That I have knowledge of
the facts, statements, and matters herein contained and the log of the above-described well
as filed and that the same are true and correct. So help me God.

(Signature) Jack L Kaiser
Wichita, Kansas
(Address)

SUBSCRIBED AND SWORN TO before me this 20th day of January, 19

PHYLLIS BUCHANAN
NOTARY PUBLIC
STATE OF KANSAS
My Appt. Expires Jan. 2, 1984

Phyllis Buchanan
Phyllis Buchanan Notary Public.

My commission expires

API No. 1500721067 0000

KANSAS DRILLING LOG

COMPANY: Wild Boys Land Cattle & Oil Co., Ltd. Description: NE SE
Well Name: Schrock #1 Location: 10-35S-10W
County: Barber
Rotary Total Depth: 5375'
Spud Date: January 2, 1981 Rotary Complete: January 13, 1981
Contractor: Trans-Pac Drilling, Inc.
Date: January 20, 1981

Casing: Elevation: 1278 K.B.

- 13 3/8"
10 3/4"
8 5/8" Ran 8 jts. 316.50' new 20# set at 325' w/275 sx common & 3% CC 2% gel
5 1/2"
4 1/2"

Figures Indicate Bottom of Formations

Table with 3 columns: Depth (e.g., 0-445), Formation (e.g., Red Bed), and Test Results (e.g., DST #1 4727-4790, IBHCIP 1232 psi).

RECEIVED
FEB - 6 1981
CONSERVATION DIVISION
Wichita, Kansas

I hereby certify the above and foregoing to be a true and correct log of the above described well as shown by the drilling reports.

TRANS-PAC DRILLING, INC.
Charles R. King

State of Kansas)
County of Sedgwick) ss:

Subscribed and sworn to before me a Notary Public in and for said county and state this 20th day of January, 19 81.

My Appointment Expires:

Phyllis Buchanan
Notary Public
Phyllis Buchanan

