


Give All Information Completely
Make Required Affidavit
Mail or Deliver Report to:
Conservation Division
State Corporation Commission
212 No. Market
Wichita, Kansas

WELL PLUGGING RECORD

15 051 23032.00 00

NORTH

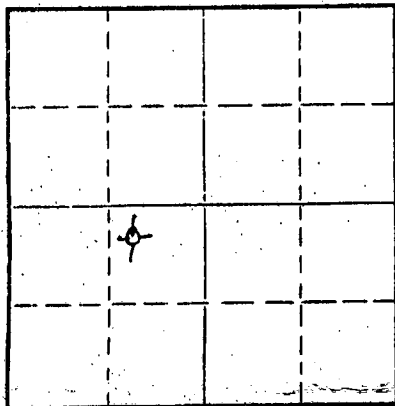

Locate well correctly on above
Section Plat

Ellis County, Sec. 26 Twp. 13 Rge. 18 (W)
Location as "NE/CNW/SE" or footage from lines NW NE SW
Lease Owner Michael D. Weillert Oil
Lease Name Nease Well No. #1
Office Address Box 988 Hays, Ks. 67601
Character of Well (completed as Oil, Gas or Dry Hole) Dry Hole
Date well completed 6-7 19 82
Application for plugging filed 6-7 19 82
Application for plugging approved 6-7 19 82
Plugging commenced 6-7 19 82
Plugging completed 6-7 19 82
Reason for abandonment of well or producing formation Dry Hole

If a producing well is abandoned, date of last production 19
Was permission obtained from the Conservation Division or its agents before plugging was commenced? Yes

Name of Conservation Agent who supervised plugging of this well Glibert Scheck
Producing formation Depth to top Bottom Total Depth of Well 3630' Feet
Show depth and thickness of all water, oil and gas formations.

OIL, GAS OR WATER RECORDS

CASING RECORD

FORMATION	CONTENT	FROM	TO	SIZE	PUT IN	PULLED OUT
Surface		0	249'	8 5/8"	249'	0

Describe in detail the manner in which the well was plugged, indicating where the mud fluid was placed and the method or methods used in introducing it into the hole. If cement or other plugs were used, state the character of same and depth placed, from feet to feet for each plug set.

1st. Plug set at 720' with 70 sacks common cement 50-50 Poz 3% Cal Cl 4% Gel

2nd. Plug set at 230' with 40 sacks common cement 50-50 Poz 3% Cal Cl 4% Gel

3rd. Plug set at 40' with 10 sacks common cement 50-50 Poz 3% Cal Cl 4% Gel

10 sacks in rathole

Heavy drilling mud between each plug.

(If additional description is necessary, use BACK of this sheet)

Name of Plugging Contractor Sun Oilwell Cementing
Address Hays, Ks. 67601

STATE OF Kansas COUNTY OF Graham ss.
Jerry M. Helberg

(employee of owner) or (owner or operator) of the above-described well, being first duly sworn on oath, says: That I have knowledge of the facts, statements, and matters herein contained and the log of the above-described well as filed and that the same are true and correct. So help me God.

(Signature)

Box 32 Morland, Ks. 67650
(Address)

SUBSCRIBED AND SWORN TO before me this 11 day of June, 1982

My commission expires

Notary Public.

