


STATE OF KANSAS
STATE CORPORATION COMMISSION

Form CP-4

Give All Information Completely
Make Required Affidavit
Mail or Deliver Report to:
Conservation Division
State Corporation Commission
212 No. Market
Wichita, Kansas

15-051-20327-00-06
WELL PLUGGING RECORD

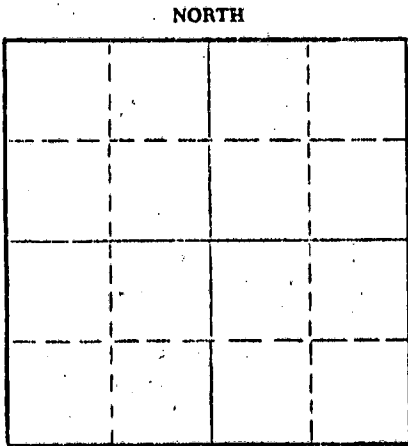

Locate well correctly on above Section Plat

Ellis County, Sec. 4 Twp. 13S Rge. 19 (E) W (W)
Location as "NE/CNW/SE" or footage from lines NW NW SE
Lease Owner Raymond Oil Company
Lease Name Orth Well No. 1
Office Address 410 Fourth National Bank Bldg.-Wichita, Kansas
Character of Well (completed as Oil, Gas or Dry Hole) D & A
Date well completed October 9, 1968
Application for plugging filed October 9, 1968
Application for plugging approved October 9, 1968
Plugging commenced October 9, 1968
Plugging completed October 9, 1968
Reason for abandonment of well or producing formation D & A

If a producing well is abandoned, date of last production 19
Was permission obtained from the Conservation Division or its agents before plugging was commenced? Yes

Name of Conservation Agent who supervised plugging of this well Leo F. Massey
Producing formation Depth to top Bottom Total Depth of Well 3853 Feet
Show depth and thickness of all water, oil and gas formations.

OIL, GAS OR WATER RECORDS

CASING RECORD

FORMATION	CONTENT	STATE	TO	SIZE	PUT IN	PULLED OUT
				8 5/8"	227.15	-0-

RECEIVED FROM TO
CORPORATION COMMISSION
OCT 21 1968
CONSERVATION DIVISION
Wichita, Kansas

Describe in detail the manner in which the well was plugged, indicating where the mud fluid was placed and the method or methods used in introducing it into the hole. If cement or other plugs were used, state the character of same and depth placed, from feet to feet for each plug set.


Plug @ 660' w/70 sx cement,
plug @ 210' w/ 20 sx cement,
plug @ 40' w/10 sx cement

(If additional description is necessary, use BACK of this sheet)

Name of Plugging Contractor Red Tiger Drilling Company
Address 1720 Wichita Plaza Bldg.-Wichita, Kansas 67202

STATE OF Kansas COUNTY OF Sedgwick, ss.
Norman E. Klein (employee of owner) or (owner or operator) of the above-described well, being first duly sworn on oath, says: That I have knowledge of the facts, statements, and matters herein contained and the log of the well as filed and that the same are true and correct. So help me God.

(Signature) Norman E Klein
1720 Wichita Plaza-Wichita, Kansas
(Address)

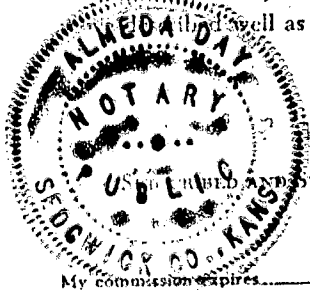

My commission expires September 9, 1969
Sworn to before me this 17th day of October, 1968
Almeda Day Notary Public

DRILLERS LOG

15-051-20327-00-00

No. 1 Orth

CASING RECORD

COMPANY: Raymond Oil Company

DESCRIPTION:

8 5/8" @ 234'
w/165 sx cement

CONTRACTOR: Red Tiger Drilling Company

NW NW SE
4-13S-19W
Ellis County, Kansas

TOTAL DEPTH: 3853'

COMMENCED: September 30, 1968

COMPLETED: October 9, 1968

ELEVATION:

<u>FORMATION</u>	<u>FROM</u>	<u>TO</u>	<u>REMARKS</u>
Post rocks	0	40	
Shale	40	970	
Sand	970	1185	
Shale	1185	1365	
Shale & redbed	1365	1497	
Anhydrite	1497	1534	
Shale & shells	1534	2060	
Shale and lime	2060	2350	
Lime w/shale streaks	2350	2505	
Lime and shale	2505	3260	
Lime	3260	3790	
Lime conglomerate sand	3790	3825	
Lime	3825	3853	

RECEIVED
STATE CORPORATION COMMISSION
OCT 21 1968
CONSERVATION DIVISION
Wichita, Kansas

I certify that this is a true and correct copy of the above log to the best of my knowledge.

RED TIGER DRILLING COMPANY

Norman E. Klein
Norman E. Klein

Subscribed and sworn to before me this 17th day of October, 1968.

Almeda Day
Notary Public - Almeda Day

ALMEDA DAY
NOTARY PUBLIC
My Commission Expires
10/17/68

September 9, 1969