


STATE OF KANSAS
STATE CORPORATION COMMISSION

15-051-21335-00-00
WELL PLUGGING RECORD

Give All Information Completely
Make Required Affidavit
Mail or Deliver Report to
Conservation Division
State Corporation Comm.
245 North Water
Wichita, KS 67202

Ellis County. Sec. 4 Twp. 13S Rge. 19W E/W
Location as "NE/CNW 1/4 SW 1/4" or footage from lines
C - NW NE NW
Lease Owner Robert M. Euwer
Lease Name Weber Well No. 1
Office Address Suite 206, Litwin Bldg, 110 N. Market
Character of Well (Completed as Oil, Gas or Dry Hole)

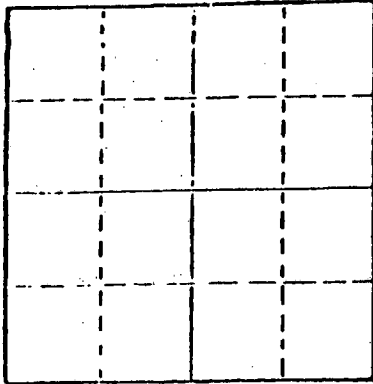

Locate well correctly on above
Section Plat

Dry Hole
Date Well completed June 16, 1977
Application for plugging filed Verbal Application 1977
Application for plugging approved Verbal Approval 1977
Plugging commenced June 16, 1977
Plugging completed June 16, 1977
Reason for abandonment of well or producing formation

If a producing well is abandoned, date of last production 19

Was permission obtained from the Conservation Division or its agents before plugging was commenced? Yes

Name of Conservation Agent who supervised plugging of this well Leo Massey
Producing formation Depth to top Bottom Total Depth of Well 3860'
Show depth and thickness of all water, oil and gas formations.

OIL, GAS OR WATER RECORDS

CASING RECORD

FORMATION	CONTENT	FROM	TO	SIZE	PUT IN	PULLED OUT
				8 5/8"	257'	none

Describe in detail the manner in which the well was plugged, indicating where the mud fluid was placed and the method or methods used in introducing it into the hold. If cement or other plugs were used, state the character of same and depth placed, from feet to feet for each plug set.

Filled hole with heavy rotary mud from 3,860 ft. (rotary total depth) to 550' ft. Set plug at 550 ft. and cemented with 70 sacks cement. Filled hole with heavy rotary mud from 550 ft. to 240 ft. Set plug at 240 ft. and cemented with 40 sacks cement. Filled hole with heavy rotary mud from 240 ft. to 40 ft. Set solid plug at 40 ft. and cemented to cellar with 10 sacks cement, 2 sacks cement in rat hole.

RECEIVED
STATE CORPORATION COMMISSION
6-24-77
JUN 24 1977

(If additional description is necessary, use BACK of this sheet)
Name of Plugging Contractor Halliburton Services
CONSERVATION DIVISION
Wichita, Kansas

STATE OF Kansas COUNTY OF Sedgwick, ss.
Dean Britting Agent (employee of owner) ~~xxx (owner) xxx (operator)~~
of the above-described well, being first duly sworn on oath, says: That I have knowledge of the facts, statements, and matters herein contained and the log of the above-described well as filed and that the same are true and correct. So help me God.

(Signature) Dean Britting
200 N. Main, Wichita, KS 67202
(Address)

SUBSCRIBED AND SWORN TO before me this 23rd day of June, 1977

My commission expires June 30, 1978
Elsie Willison - Notary Public.



KANSAS GEOLOGICAL SOCIETY
KANSAS WELL LOG BUREAU - KANSAS WELL SAMPLE BUREAU
KANSAS GEOLOGICAL SOCIETY BUILDING
508 EAST MURDOCK - WICHITA, KANSAS

COMPANY Robert M. Euwer

SEC. 4 T. 13S R. 19W
LOC. C-NW NE NW

FARM Weber NO. 1


COUNTY Ellipton KANSAS

TOTAL DEPTH 3,860'

COMP. June 16, 1977

COMM. June 4, 1977

CONTRACTOR H-30, Inc.
ISSUED June 23, 1977

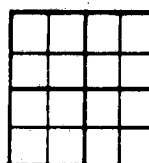

CASING

20	10		ELEVATION 2159 KB
15	8		
12	6	5/8" 257' cemented w/ 200 sxs cement	
13	5		PRODUCTION

FIGURES INDICATE BOTTOM OF FORMATIONS

Surface Soil	65'
Clay and Shale	200'
Shale	970'
Sand and Red Bed	1,494'
Anhydrite	1,539'
Shale and Shells	1,653'
Shale and Lime	2,160'
Lime and Shale	3,306'
Lime	3,860'
Rotary Total Depth	3,860'

RECEIVED
STATE CORPORATION COMMISSION

JUN 24 1977

CONSERVATION DIVISION
Wichita, Kansas

I hereby certify the above and foregoing to be a true and correct log of the above described well as shown by the drilling reports.

H-30, Inc.

Dean Britting
Dean Britting

State of Kansas }
County of Sedgwick } ss:

Subscribed and Sworn to before me a Notary Public in and for said county and state this 23rd day of June,

Elsie Willison
Elsie Willison - Notary Public



Commission Expires:
June 30, 1978