


STATE OF KANSAS  
STATE CORPORATION COMMISSION

15051-22284 00-00  
WELL PLUGGING RECORD

Give All Information Completely  
Make Required Affidavit  
Mail or Deliver Report to  
Conservation Division  
State Corporation Comm.  
245 North Water  
Wichita, KS 67202

Ellis County, Sec. 4 Twp. 13 Rge. 19 E/W  
Location as "NE/CNW $\frac{1}{4}$ SW $\frac{1}{4}$ " or footage from lines  
NE SE NW

Lease Owner Staab Oil Company  
Lease Name Weber-Victory Life Well No. 1  
Office Address Catherine Rt. Box 39 Hays, Kansas 67601  
Character of Well (Completed as Oil, Gas or Dry Hole)

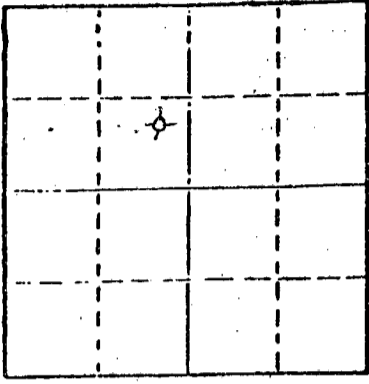

Locate well correctly on above  
Section Plat

Dry Hole  
Date Well completed March 15 1981  
Application for plugging filed March 15 1981  
Application for plugging approved March 15 1981  
Plugging commenced March 15 1981  
Plugging completed March 15 1981  
Reason for abandonment of well or producing formation

Dry Hole  
If a producing well is abandoned, date of last production 19

Was permission obtained from the Conservation Division or  
its agents before plugging was commenced? Yes

Name of Conservation Agent who supervised plugging of this well Marion Schmidt  
Producing formation Depth to top Bottom Total Depth of Well 3860'  
Show depth and thickness of all water, oil and gas formations.

OIL, GAS OR WATER RECORDS

CASING RECORD

FORMATION	CONTENT	FROM	TO	SIZE	PUT IN	PULLED OUT
Surface		0	231'	8 5/8	231'	0

Describe in detail the manner in which the well was plugged, indicating where the mud fluid was placed and the method or methods used in introducing it into the hold. If cement or other plugs were used, state the character of same and depth placed, from feet to feet for each plug set.

1st Plug set at 780' with 65 sacks cement 50-50 poz 6% gel

2nd Plug set at 240' with 30 sacks cement 50-50 poz 6% gel

3rd Plug set at 40' with 10 sacks cement 50-50 poz 6% gel

5 sacks in rathole

(If additional description is necessary, use BACK of this sheet)

Name of Plugging Contractor Sun Oilwell Cementing, Inc.

RECEIVED  
STATE CORPORATION COMMISSION  
MAR 27 1981  
WICHITA, KANSAS  
CONSERVATION DIVISION

STATE OF Kansas COUNTY OF Graham

Jerry M. Halberg (employee of owner, owner or operator)

of the above-described well, being first duly sworn on oath, says: That I have knowledge of the facts, statements, and matters herein contained and the log of the above-described well as filed and that the same are true and correct. So help me God.

(Signature)

Box 32 Morland, Kansas 67650


(Address)

SUBSCRIBED AND SWORN TO before me this 26 day of March 25, 19 81

Jessie Robinson  
Notary Public.

My commission expires

12-4-83

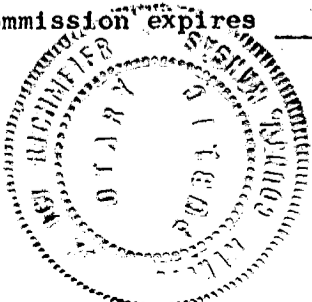

15-051-2228400-00

DRILLERS LOG

WEBER #1

CASING RECORD: OPERATOR: Stabb Oil Company

8 5/8" set at 231' CONTRACTOR: Helberg Oil Company

TOTAL DEPTH: COMMENCED: March 6, 1981

3860' COMPLETED: March 15, 1981

DESCRIPTION:

NE SE NW  
Sec. 4- 13 19 Ellis County, Kansas

FORMATION	FROM	TO	REMARKS
Sand	0	251	
Sand & Shale	251	570	
Sand & Shale	570	1445	
Andhydrite & Shale	1445	1658	
Shale	1658	2065	
Shale	2065	2245	
Shale	2245	2384	
Lime & Shale	2384	2561	
Shale	2561	2783	
Shale	2783	2951	
Shale	2951	3100	
Shale	3100	3242	
Shale	3242	3351	
Lime & Shale	3351	3415	
Lime & Shale	3415	3455	
Lime	3455	3523	
Lime	3523	3550	
Lime	3550	3559	
Lime	3559	3588	
Lime	3588	3634	
Lime	3634	3688	
Lime	3688	3731	
Lime	3731	3804	
Lime	3804	3860	
T.D.	3860		

I certify that the above is a true and correct copy of the log to the best of my knowledge.

HELBERG OIL COMPANY

Jerry M. Helberg

Subscribed and sworn to before me this 26 day of March, 1981.

Notary Public

My commission expires

12-4-83

RECEIVED  
MAR 27 1981  
CONSERVATION DIVISION  
Wichita, Kansas

