


Give All Information Completely
Make Required Affidavit
Mail or Deliver Report to:
Conservation Division
State Corporation Commission
800 Bittig Building
Wichita, Kansas

OR

Strike out upper line
when reporting plug-
ging off formations.

FORMATION PLUGGING RECORD

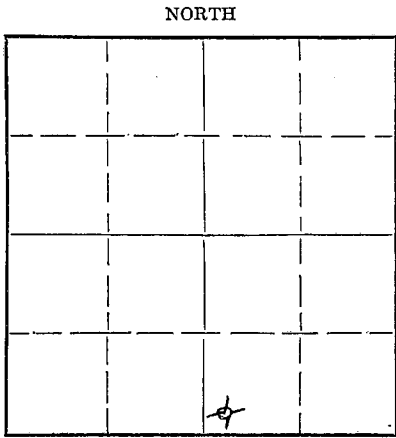

Locate well correctly on above
Section Plat

Ellis County. Sec. 23 Twp. 13 Rge. (E) 19 (W)
Location as "NE 1/4 NW 1/4 SW 1/4" or footage from lines SW SW SE
Lease Owner Virginia Drilling Company, Inc.
Lease Name Krueger Well No. 1
Office Address 701 Brown Building, Wichita 2, Kansas
Character of Well (completed as Oil, Gas or Dry Hole) Dry hole
Date well completed January 16 1949
Application for plugging filed January 16 1949
Application for plugging approved January 16 1949
Plugging commenced January 16 1949
Plugging completed January 16 1949
Reason for abandonment of well or producing formation Dry hole

If a producing well is abandoned, date of last production 19
Was permission obtained from the Conservation Division or its agents before plugging was com-
menced? Yes

Name of Conservation Agent who supervised plugging of this well C. D. Stough
Producing formation Depth to top Bottom Total Depth of Well 3750 Feet
Show depth and thickness of all water, oil and gas formations.

OIL, GAS OR WATER RECORDS

CASING RECORD

Formation	Content	From	To	Size	Put In	Pulled Out
				8-5/8"	162	
				4 1/2"	3749	2216

Describe in detail the manner in which the well was plugged, indicating where the mud fluid was placed and the method or methods used in introducing it into the hole. If cement or other plugs were used, state the character of same and depth placed, from feet to feet for each plug set.
Filled hole with mud to 250'. Set rock bridge. Dumped 15 sax cement.
Filled hole with mud to 30'. Set rock bridge. Dumped 10 sax cement for cap.

RECEIVED
Conservation Division
JAN 26 1949
26-49
STATE CORPORATION
COMMISSION
KANSAS

(If additional description is necessary, use BACK of this sheet)

Correspondence regarding this well should be addressed to Virginia Drilling Company, Inc.
Address 701 Brown Building, Wichita 2, Kansas

STATE OF Kansas, COUNTY OF Sedgwick, ss.
S. A. Murphy (employee of owner) or (owner or operator) of the above-described well,
being first duly sworn on oath, says: That I have knowledge of the facts, statements, and matters herein contained and the log of the above-described well as filed and that the same are true and correct. So help me God.

(Signature) S. A. Murphy
701 Brown Building, Wichita 2, Kansas
(Address)

SUBSCRIBED AND SWORN to before me this 25th day of January 1949
My commission expires 2/5/49
Notary Public.



22-2625 2-18-15M
PLUGGING
FILE SEC 23 T 13 R 1949
BOOK PAGE 80 LINE 39

Well: Krueger No. 1
 Location: SW SE Section 23-18S-19W, Ellis County, Kansas
 Company: Virginia Drilling Company, Inc.
 Contractor: Virginia Drilling Company, Inc.
 Commenced: October 8, 1948
 Completed: October 26, 1948
 Total Depth: 3750
 Elevation: 2050

15-051-00012-0000

FORMATION	DEPTH		
12 $\frac{1}{2}$ hole	0-72	Set 8-5/8 csg. @ 162	
	72-162	Set 4 $\frac{1}{2}$ " csg. @ 3749	
		TOPS:	
Shale-shells	162-810		
Sand	810-1015	Heebner	3326
Shale-red bed	1015-1145	Toronto	3347
Sandy red bed - shale	1145-1337	Lansing	3376
Anhydrite	1337-1392	Base Kansas City	3634
Shale-red bed	1392-1540	Marmaton cherty lime	3696
Shale	1540-1695		
Shale-shells	1695-1930		
Shale-lime	1930-2350		
Lime	2350-2408		
Lime-shale	2408-2910		
Shale-shells	2910-3050	CIRCULATE:	
Shale-lime	3050-3406	3251 - 1 hr 20 min	
KC Lime	3406-3483	3295 - 1 hr 20 min	
Lime	3483-3614	3459 - 2 hrs	
Lime-shale	3614-3663	3750 - 1 $\frac{1}{2}$ hrs	
Conglomerate	3663-3697		
Arbuckle lime	3697-3750		

Now comes S. A. Murphy, who states that he is familiar with the drilling of oil and gas wells and knows of his own knowledge that the Krueger No. 1, located in the SW SE Section 23-18S-19W, Ellis County, Kansas, was drilled to a total depth of 3750 feet. Same was plugged and abandoned.

Subscribed and sworn to before me this 25th day of January, 1949.

S. A. Murphy

Conrad E. [Signature]

My commission expires February 5, 1949.

RECORDED
 INDEXED
 FEB 23 12 1949
 80-1139