Kansas Corporation Commission Oil & Gas Conservation Division

ORIGINAL

Form ACO-1
June 2009
Form Must Be Typed
Form must be Signed
All blanks must be Filled

WELL COMPLETION FORM WELL HISTORY - DESCRIPTION OF WELL & LEASE

OPERATOR: License #	API No. 15 - 125-30070-01-00
Name: CEP MID CONTINENT LLC	Spot Description:
Address 1: 15 WEST 6TH ST SUITE 1100	SW_NE_NE_ Sec. 8 Twp. 34 S. R. 15 ▼ East West
Address 2:	410 Feet from North / South Line of Section
City: TULSA State: OK Zip: 74119 +	738 Feet from ☐ East / ✓ West Line of Section
MOMENADTED	
Phone: (918) 877-2923 (ANSAS CORPORATION COMMISS)	™ □NE □NW □SE □SW
CONTRACTOR: License #	County: MONTGOMERY
CONTRACTOR: License #	Lease Name: WHEELER HADDEN Well #: 8-1
	Field Name: CHEROKEE BASIN COAL AREA
MEDIE	Producing Formation: RIVERTON
Purchaser:	Elevation: Ground: 862 Kelly Bushing:
Designate Type of Completion:	Total Depth: 2909 Plug Back Total Depth:
☐ New Well	Amount of Surface Pipe Set and Cemented at: Feet
Oil Wsw SwD Slow	Multiple Stage Cementing Collar Used? Yes No
☐ Gas ☐ D&A ☐ ENHR ☐ SIGW ☐ Temp. Abd.	If yes, show depth set:Feet
CM (Coal Bed Methane)	
☐ Cathodic ✓ Other (Core, Expl., etc.): LATERAL SIDETRACK IN EXISTING WELL	If Alternate II completion, cement circulated from:sx cmt.
If Workover/Re-entry: Old Well Info as follows:	feet depth to:w/sx cirit.
Operator: SUNWEST PETROLEUM INC	
Well Name: WHEELER HADDEN 8-1	Drilling Fluid Management Plan (Data must be collected from the Reserve Pit)
Original Comp. Date: 1-21-02 Original Total Depth: 1443	
Deepening Re-perf. Conv. to ENHR Conv. to SWD	Chloride content:ppm Fluid volume:bbls
Conv. to GSW	Dewatering method used:
Plug Back: Plug Back Total Depth	Location of fluid disposal if hauled offsite:
Commingled Permit #:	Operator Name:
Dual Completion Permit #:	Lease Name: License #:
SWD Permit #:	Quarter Sec Twp S. R
ENHR Permit #:	County: Permit #:
GSW Permit #:	
8-4-10	
Recompletion Date Recompletion Date	
INSTRUCTIONS: An original and two copies of this form shall be filed with Kansas 67202, within 120 days of the spud date, recompletion, workover or co of side two of this form will be held confidential for a period of 12 months if req tiality in excess of 12 months). One copy of all wireline logs and geologist we BE ATTACHED. Submit CP-4 form with all plugged wells. Submit CP-111 for	unversion of a well. Rule 82-3-130, 82-3-106 and 82-3-107 apply. Information uested in writing and submitted with the form (see rule 82-3-107 for confidentification) is report shall be attached with this form. ALL CEMENTING TICKETS MUST
	V00 0/7 - U - 0\UV
AFFIDAVIT I am the affiant and I hereby certify that all requirements of the statutes, rules and r	KCC Office Use ONLY
lations promulgated to regulate the oil and gas industry have been fully complied	with Letter of Confidentiality Received
and the statements herein are complete and correct to the best of my knowledg	
(1) (b. Lasta)	☐ Confidential Release Date:
Signature; MUTATION TO THE SIGNATURE	Geologist Report Received

Operator Name: <u>CE</u>	P MID CONTINEN	IT LLC	Lease N	lame: _	WHEELER H	ADDEN	_ Well #:8-1		
Sec. 8 Twp. 34	s. R. <u>15</u>	✓ East	County:	County: MONTGOMERY					
time tool open and clorecovery, and flow rat	now important tops and osed, flowing and shut- es if gas to surface tes Attach final geological v	in pressures, whether t, along with final char	r shut-in press	ure read	ched static level,	hydrostatic pres	sures, bottom h	nole temperature,	fluid
Drill Stem Tests Taker (Attach Additional		Yes No		ØL	og Formatio	n (Top), Depth a	nd Datum	Sample	
Samples Sent to Geo	logical Survey	☐ Yes ✓ No		Nam	e		Тор	Datum	
Cores Taken Electric Log Run Electric Log Submitte (If no, Submit Copy	•	Yes No Yes No Yes No		RIVER	RTON		1324	-462	
List All E. Logs Run:									
		CACINI	C DECORD	☐ Ne	w Used	5 - EVE. 211-211		-	
:		Report all strings se	G RECORD et-conductor, sur	_		ion, etc.		``	
Purpose of String	Size Hole Drilled	Size Casing Set (In O.D.)	Weig Lbs./		Setting Depth	Type of Cement	# Sacks Used	Type and Perce Additives	≱nt
<u> </u>		ADDITION	AL CEMENTIN		I JEEZE RECORD	<u></u>		<u></u>	
Purpose:	Depth Top Bottom	Type of Cement	# Sacks	Used		Type and	Percent Additives		
Protect Casing Plug Back TD									
Plug Off Zone									
Shots Per Foot		ON RECORD - Bridge Plootage of Each Interval F				cture, Shot, Cemer mount and Kind of M		d Dep	th
4/FT.	RIVERTON				ACID 1000	GALS 15% HC	L	1324-	27
							KANCAC CODD		
						-	JAKOD CACARA	PRATION COMMISSI	ION
							JAN	1 2 2011	
TUBING RECORD:	Size: 2 7/8	Set At: 1335	Packer At		Liner Run:	Yes ☑ N		EIVED	
Date of First, Resumed	Production, SWD or EN	1 *	lethod:		Gas Lift (24h - 1 (F)			
Estimated Production Per 24 Hours	10-27- Oil E	Bbls. Gas	Mcf 4	Wat		Other (Explain) —— Bbls.	Gas-Oil Ratio	Gravit	у
		<u> </u>	<i></i>						
DISPOSIT	ION OF GAS:		METHOD OF	COMPLI	ETION:		PRODUCTI	ON INTERVAL:	
Vented ✓ Sol	d Used on Lease	Open Hole	Perf.	(Submit	ACO-5) (Sub	mmingled <u>f</u> omit ACO-4)	RIVERTON 13	24-1327	

Side Two

perator Name: <u>CEP</u>	MID CONTINEN	NT LLC		Lease Name: WHEELER HADDEN. Well #: 8-1						
ec. 8 Twp.34	s. r. <u>15</u>	✓ East West	County	County: MONTGOMERY						
NSTRUCTIONS: Show me tool open and close ecovery, and flow rates ne Logs surveyed. Atta	ed, flowing and shut if gas to surface tes	-in pressures, whethe st, along with final cha	r shut-in press	sure reache	d static level	, hydrostatic pre	ssures, bottom ho	ole temperature, fluid		
Drill Stem Tests Taken				✓ Log Formation (Top), Dep		n (Top), Depth a	and Datum	Sample		
Cores Taken Yes Electric Log Run		□ Yes ☑ No	Yes No				Top 1324	Datum -462		
		Yes No					1024			
ist All E. Logs Run: Scientific Drillin	g logs									
		CASII Report all strings s	NG RECORD	New urface, interm	Used	tion, etc.				
Purpose of String	Size Hole Drilled	Size Casing Set (In O.D.)	Wei	ght	Setting Depth	Type of Cement	# Sacks Used	Type and Percent Additives		
		William Control								
				NO (20) IF	75 05000					
	Death		NAL CEMENTI		ZE RECORL		d Decemb Additions			
Purpose: —— Perforate —— Protect Casing —— Plug Back TD —— Plug Off Zone	Depth Top Bottom	Type of Cement	# Sacks	s Used		туре ап	d Percent Additives			
Shots Per Foot PERFORATION RECORD - Br Specify Footage of Each Int			Plugs Set/Type Perforated			acture, Shot, Cem Amount and Kind of		Depth		
	- <u> </u>	199			2.000	# 16/30 NIFOAM.	DAND 100	1324-290		
					500 g	al 15%	sacid p	ad		
					<u> </u>		MIN	SAS CORPORATION COMP		
TUBING RECORD:	Size:	Set At:	Packer /	At:	Liner Run:	Yes	No [JAN 12 2011 RECEINATED		
Date of First, Resumed F	Production, SWD or EN $0-27-16$			ing G	as Lift 🔲	Other (Explain)				
Estimated Production Per 24 Hours	Oil	Bbls. Gas	Mcf	Water		Bbls.	Gas-Oil Ratio	Gravity		
DISPOSITIO	ON OF GAS:			F COMPLET	ION:		PRODUCTION INTERVAL:			
Vented ✓ Sold	Used on Lease	Open Hole	Perf.	Dually C (Submit AC)	O-5) (Su	ommingled ubmit ACO-4)	lateral length 1	378'		

Actula Re-entry Wheeler-Haddan 8-1 Wellbore Diagram

Actual Surface Loc: NW/4 Sec 08 T34S – R15E – Kanmap Actual Surface Loc: 410' FNL, 738' FWL, ELEV 819.2'


Actual BHL for Weir-Pitt Lateral: SW/4 Sec 05 T34S - R15E - Sunwest

Actual BHL, Start of Target: 161.1' FNL, 807.5' FWL Sec 08

Actual BHL, End of Target: 1,201.3' FSL, 1009' FWL Sec 05, 12.7° Azim

Actual Vertical Section: 1693.9' Actual Lateral Length: 1,378' Horizontal Sidetrack Riverton Coal

Casing	Size	Wt	# Jts.	Length	MD	TVD
Surface Casing	8.625	N/A	N/A	21.00	21.00	21
Orig. Production Csg	5.5	N/A	N/A	1,395.00	1,395.00	1,395
				N COMMISSION 2011		

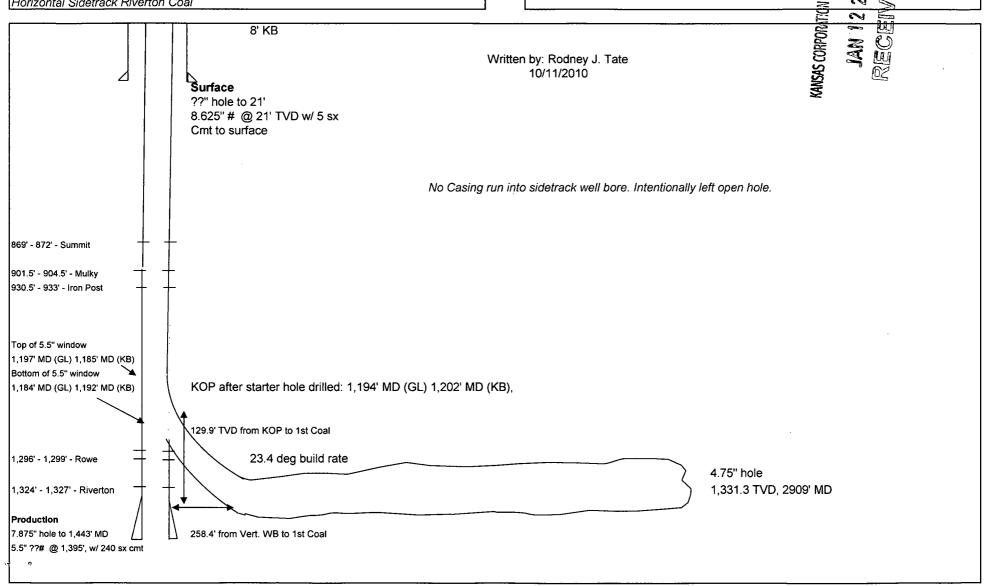

Date Printed: 10/11/2010 8:50 AM