


STATE OF KANSAS
STATE CORPORATION COMMISSION

15-051-000 84-00-00

WELL PLUGGING RECORD

Give All Information Completely
Make Required Affidavit
Mail or Deliver Report to:
Conservation Division
State Corporation Commission
800 Bitting Building
Wichita, Kansas

NORTH

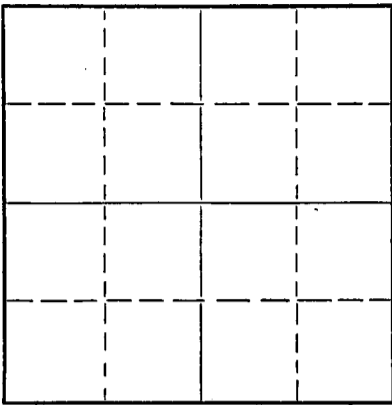

Locate well correctly on above
Section Plat

Ellis County, Sec. 4 Twp 13 S Rge 18 (E) (W)

Location as "NE/CNW $\frac{1}{4}$ SW $\frac{1}{4}$ " or footage from lines NW $\frac{1}{4}$, NW $\frac{1}{4}$, NW $\frac{1}{4}$

Lease Owner Graham-Messman-Rinehart Oil Company

Lease Name Reemsnyder Well No. 1

Office Address 204 N. Market, Wichita, Kansas

Character of Well (completed as Oil, Gas or Dry Hole) Dry Hole

Date well completed March 9 19 52

Application for plugging filed verbally March 9 19 52

Application for plugging approved verbally March 9 19 52

Plugging commenced March 9 19 52

Plugging completed March 9 19 52

Reason for abandonment of well or producing formation Dry Hole

If a producing well is abandoned, date of last production 19

Was permission obtained from the Conservation Division or its agents before plugging was commenced? Yes

Name of Conservation Agent who supervised plugging of this well Eldon Petty

Producing formation Depth to top Bottom Total Depth of Well 3867 Feet

Show depth and thickness of all water, oil and gas formations.

OIL, GAS OR WATER RECORDS

CASING RECORD

Formation	Content	From	To	Size	Put In	Pulled Out
		0	166'	8 5/8"	166'	None

Describe in detail the manner in which the well was plugged, indicating where the mud fluid was placed and the method or methods used in introducing it into the hole. If cement or other plugs were used, state the character of same and depth placed, from feet to feet for each plug set.

Filled hole with heavy mud to 165'. Set bottom plug at 165' and filled hole with 15 sacks of cement. Set top plug at 40' and filled hole to top of pipe with 10 sacks of cement.

03-18-1952

(If additional description is necessary, use BACK of this sheet)

Name of Plugging Contractor Walters Drilling Co., Inc.

Address 500 Orpheum Building, Wichita, Kansas

STATE OF KANSAS, COUNTY OF SEDGWICK, ss.

Robert F. Walters (employee of owner) or (owner/operator) of the above-described well,

being first duly sworn on oath, says: That I have knowledge of the facts, statements, and matters herein contained and the log of the above-described well as filed and that the same are true and correct. So help me God.

(Signature) Robert F. Walters

(Address)


SUBSCRIBED AND SWORN TO before me this 11th day of March, 1952.

D. Marjorie Matt

Notary Public.

My commission expires June 28, 1952

23-8390-s 6-51-20M

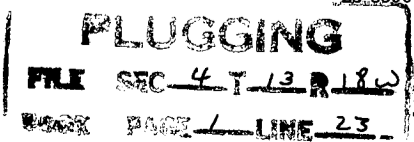

REEMSnyder WELL NO. 1

Location:	NW NW NW Sec. 4-13S-18W Ellis County, Kansas	Date Spudded: 2-27-52
Operator:	Graham-Messman-Rinehart Oil Company	Rotary Completion: 3-9-52
Contractor:	Walters Drilling Co., Inc.	Elevation: 2175' Gr. 2177' DF 2179' KB
Surface Casing:	8 5/8" set @ 166' with 115 sacks cement and 1 sack Cal. Chloride.	

L O G

(Figures indicate bottom of formation)

Surface	0 to 166
Shale and Sand	445
Shale	704
Sand	860
Shale	925
Sand	1175
Shale	1471
Anhydrite	1510
Shale and Shells	1875
Lime and Shale	1980
Shale and Shells	2446
Lime and Shale	2865
Shale	3041
Shale and Lime	3160
Shale	3208
Lime	3272
Lime and Shale	3770
Conglomerate	3867
Total Depth (Rotary)	3867

The undersigned, Robert F. Walters, hereby certifies that the above log is a true and correct log of the formations encountered in drilling the above noted well as reflected by the Daily Drilling Reports.

WALTERS DRILLING CO., INC.

By Robert F. Walters

Subscribed and sworn to before me
this 11th day of March, 1952.

D. Marjorie Mett
Notary Public

My commission expires June 28, 1952

03-18-1952

