


STATE OF KANSAS
STATE CORPORATION COMMISSION

WELL PLUGGING RECORD

Give All Information Completely
Make Required Affidavit
Mail or Deliver Report to
Conservation Division
State Corporation Comm.
245 North Water
Wichita, KS 67202

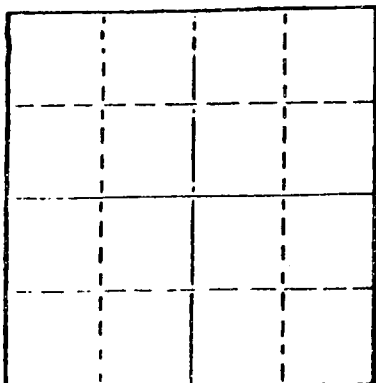

Locate well correctly on above
Section Plat

Ellis County, Sec. 14 Twp. 13S Rge. 18W ~~E/W~~
Location as "NE/CNW $\frac{1}{4}$ SW $\frac{1}{4}$ " or footage from lines
1540' FSL; 1695' FWL of SW/4
Lease Owner Graham-Michaelis Corporation
Lease Name Pfeifer Well No. 1-14
Office Address 211 North Broadway, Wichita, Ks. 67202
Character of Well (Completed as Oil, Gas or Dry Hole) D & A
Date Well completed November 22, 1978
Application for plugging filed November 22, 1978
Application for plugging approved November 22, 1978
Plugging commenced November 22, 1978
Plugging completed November 22, 1978
Reason for abandonment of well or producing formation D & A

If a producing well is abandoned, date of last production 19

Was permission obtained from the Conservation Division or its agents before plugging was commenced? Yes

Name of Conservation Agent who supervised plugging of this well Leo F. Massey
Producing formation _____ Depth to top _____ Bottom _____ Total Depth of Well 3,760'
Show depth and thickness of all water, oil and gas formations.

OIL, GAS OR WATER RECORDS

CASING RECORD

FORMATION	CONTENT	FROM	TO	SIZE	PUT IN	PULLED OUT
				13 3/8"	118'	-0-
				8 5/8"	636.67'	-0-

Describe in detail the manner in which the well was plugged, indicating where the mud fluid was placed and the method or methods used in introducing it into the hold. If cement or other plugs were used, state the character of same and depth placed, from _____ feet to _____ feet for each plug set.

Plug #1 @ 660' w/50 sx cement
Plug #2 @ 240' w/25 sx cement
Bridge @ 40' w/10 sx cement
Cement was 50-50 Pozmix, 2% Gel

RECEIVED
STATE CORPORATION COMMISSION
NOV 30 1978
11-30-78

(If additional description is necessary, use BACK of this sheet)

Name of Plugging Contractor Red Tiger Drilling Company


STATE OF Kansas COUNTY OF Sedgwick, ss. contractor
Gloria Fawcett (employee of ~~owner~~) or ~~owner~~ or ~~operator~~

of the above-described well, being first duly sworn on oath, says: That I have knowledge of the facts, statements, and matters herein contained and the log of the above-described well as filed and that the same are true and correct. So help me God.

(Signature) Gloria Fawcett
1720 KSB&T Building, Wichita, Kansas 67202
(Address)

SUBSCRIBED AND SWORN TO before me this 28th day of November, 1978.

My commission expires _____
Joyce A. Hagermann
Notary Public.

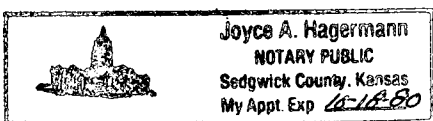

DRILLERS LOG

No. 1-14 Pfeifer

CASING RECORD:	COMPANY:	Graham-Michaelis Corporation	DESCRIPTION:
13 3/8" @ 115' w/40 sx cement	CONTRACTOR:	Red Tiger Drilling Company	1540' FSL; 1695' FWL of SW/4 Sec. 14-T13S-R18W Ellis County, Kansas
8 5/8" @ 644' w/275 sx cement	COMMENCED:	November 10, 1978	
TOTAL DEPTH: 3,760'	COMPLETED:	November 22, 1978	ELEVATION: 2,155' KB

<u>FORMATION</u>	<u>FROM</u>	<u>TO</u>	<u>REMARKS</u>
Post Rock	0	50	
	50	115	Reaming & Dry Drilling
Shale	115	1865	
Sand	865	1086	
Shale & Red Bed	1086	1418	
Anhydrite	1418	1460	
Shale & Red Bed	1460	1760	
Shale	1760	2011	
Shale & Lime	2011	2250	
Shale & Lime Streaks	2250	2450	
Shale & Lime	2450	2536	
Lime & Shale	2536	2675	
Lime	2675	3760	
RTD		3760	

I certify that this is a true and correct copy of the above log to the best of my knowledge.

RED TIGER DRILLING COMPANY


Gloria Fawcett

 Gloria Fawcett

Subscribed and sworn to before me this 28th day of November, 1978.

Joyce A. Hagermann

 Notary Public

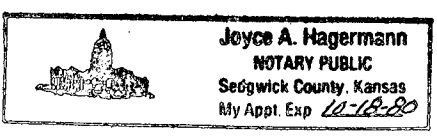

RECEIVED
 STATE CORPORATION COMMISSION
 NOV 30 1978
 CONSERVATION DIVISION
 Wichita, Kansas