

STATE OF KANSAS
STATE CORPORATION COMMISSION
200 Colorado Derby Bldg.
Wichita, Kansas 67202

*Correction on section
From sec 13 to sec 14*

WELL PLUGGING RECORD

Give All Information Completely
Make Required Affidavit.

COUNTY Ellis SEC. 14 TWP. 13 RGE. 18 E/W
Location as in quarters or footage from lines:
1320 FSL 1450' FEL

Lease Owner Revlin Drlg., Inc.
Lease Name Unrein Well No. #1
Office Address Box 293 Russell, Kansas 67665
Character of Well (Completed as Oil, Gas or Dry Hole) Dry Hole
Date Well Completed 8-23-83
Application for plugging filed 8-23-83
Plugging commenced 8-23-83 5:00 pm
Plugging completed 8-23-83 7:10 pm
Reason for abandonment of well or producing formation Dry Hole

Locate Well
correctly on above
Section Platt.

Was permission obtained from the Conservation Division or it's
Agent's before plugging was commenced? yes

Name of Conservation Agent who supervised plugging of this well Marion Schmidt

Producing formation _____ Depth to top _____ bottom _____ T.D. 3800'

Show depth and thickness of all water, oil and gas formations.

OIL, GAS OR WATER RECORDS Casing Record

Formation	Content	From	To	Size	Put in	Pulled Out

Describe in detail the manner in which the well was plugged, indicating where the mud
fluid was placed and the method or methods used in introducing it into the hold. If cement
or other plugs were used, state the character of same and depth placed, from _____ feet
to _____ feet for each plug set.

- 20 sx. @ 1410
- 80 sx. @ 750
- 40 sx. @ 240
- 10 sx @ 40 w/ solid bridge plug
- 10 sx. in rat hole circulate w/ 1 jr. of drill pipe.

Cement used was : 50-50 Poz Mix 4% Gel 3% CC


*PCW
08-26-83*

(If additional description is necessary, use BACK of this sheet)

Name of Plugging Contractor Revlin Drlg., Inc.

STATE OF Kansas COUNTY OF Russell, ss.

Stanley C. Lingreen (~~EMPLOYEE OR OWNER~~) or (owner or operator) of the
above-described well, being first duly sworn on oath, says: That I have knowledge of the
facts, statements, and matters herein contained and the log of the above-described well as
filed and that the same are true and correct. So help me God.

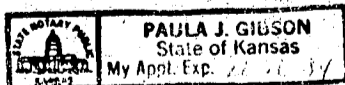

(Signature) Stanley C. Lingreen
Box 293 Russell, Kansas 67665
(Address)

SUBSCRIBED AND SWORN TO before me this 20th day of September, 1983

Paula J. Gibson
Notary Public

My Commission expires: November 10, 1984