


#5329

STATE OF KANSAS
STATE CORPORATION COMMISSION

WELL PLUGGING RECORD

15-051-23170-00-00

Give All Information Completely
Make Required Affidavit
Mail or Deliver Report to
Conservation Division
State Corporation Comm.
245 North Water
Wichita, KS 67202

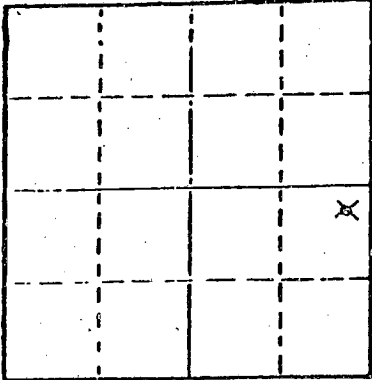

Locate well correctly on above
Section Plat

Ellis County. Sec. 17 Twp. 13 Rge. 18 E/W
Location as "NE/CNW1/4SW1/4" or footage from lines
NE NE SE

Lease Owner Dreiling Resources, Inc.

Lease Name Polifka A Well No. 1

Office Address P. O. Box 278, Victoria, KS 67671

Character of Well (Completed as Oil, Gas or Dry Hole)

Dry Hole

Date Well completed 9-23 1982

Application for plugging filed 9-23 1982

Application for plugging approved 9-23 1982

Plugging commenced 9-23 1982

Plugging completed 9-23 1982

Reason for abandonment of well or producing formation

If a producing well is abandoned, date of last production 19

Was permission obtained from the Conservation Division or
its agents before plugging was commenced? Yes

Name of Conservation Agent who supervised plugging of this well Marion Schmidt

Producing formation Depth to top Bottom Total Depth of Well 3710'

Show depth and thickness of all water, oil and gas formations.

OIL, GAS OR WATER RECORDS

CASING RECORD

FORMATION	CONTENT	FROM	TO	SIZE	PUT IN	PULLED OUT
				8 5/8"	161'	-0-

Describe in detail the manner in which the well was plugged, indicating where the mud fluid
was placed and the method or methods used in introducing it into the hold. If cement or other
plugs were used, state the character of same and depth placed, from feet to
feet for each plug set.

1st plug was set at 720' with 80 sacks

2nd plug was set at 240' with 40 sacks

3rd plug was set at 40' with 10 sacks

(If additional description is necessary, use BACK of this sheet)


Name of Plugging Contractor Dreiling Oil, Inc., Victoria, KS 67671

STATE OF Kansas COUNTY OF Ellis, ss.
Alfred J. Dreiling (employee of owner) or (owner or operator)
of the above-described well, being first duly sworn on oath, says: That I have knowledge of
the facts, statements, and matters herein contained and the log of the above-described well
as filed and that the same are true and correct. So help me God.

(Signature)

Address

SUBSCRIBED AND SWORN TO before me this 5th day of October, 1982

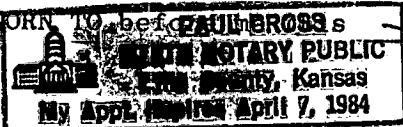

My commission expires

RECEIVED
STATE CORPORATION COMMISSION

OCT 06 1982

CONSERVATION DIVISION
Wichita, Kansas