


STATE OF KANSAS  
STATE CORPORATION COMMISSION

15-051-00700-00-00  
WELL PLUGGING RECORD

Give All Information Completely  
Make Required Affidavit  
Mail or Deliver Report to:  
Conservation Division  
State Corporation Commission  
800 Bittling Building  
Wichita, Kansas

Ellis County, Sec. 18 Twp. 13 Rge. 18 (E) (W)  
Location as "NE/CNW $\frac{1}{4}$ SW $\frac{1}{4}$ " or footage from lines SE SE NW/4  
Lease Owner Virginia Drilling Co., Inc. et al  
Lease Name Miller Well No. 1  
Office Address 701 Brown Bldg., Wichita 2, Kansas  
Character of Well (completed as Oil, Gas or Dry Hole) Dry Hole  
Date well completed November 22 1949  
Application for plugging filed November 22 1949  
Application for plugging approved November 22 1949  
Plugging commenced November 22 1949  
Plugging completed November 22 1949  
Reason for abandonment of well or producing formation

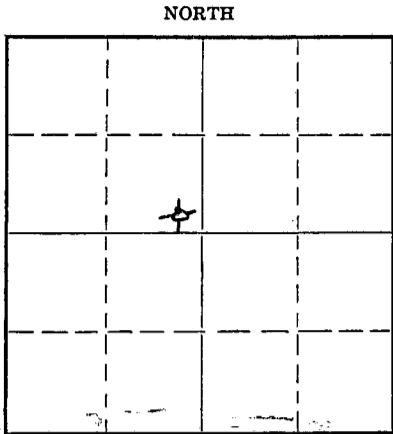

Locate well correctly on above Section Flat

If a producing well is abandoned, date of last production 19  
Was permission obtained from the Conservation Division or its agents before plugging was commenced? yes

Name of Conservation Agent who supervised plugging of this well Eldon Petty  
Producing formation Depth to top Bottom Total Depth of Well 3851 Feet  
Show depth and thickness of all water, oil and gas formations.

OIL, GAS OR WATER RECORDS

CASING RECORD

Formation	Content	From	To	Size	Put In	Pulled Out
		0	188	8-5/8"	188	none

Describe in detail the manner in which the well was plugged, indicating where the mud fluid was placed and the method or methods used in introducing it into the hole. If cement or other plugs were used, state the character of same and depth placed, from feet to feet for each plug set.

Filled hole with mud to 188 feet  
First plug set @ 188 feet - cemented with 15 sacks cement  
Second plug set @ 30 " - cemented with 10 sacks cement

RECEIVED

NOV 29 1949

STATE CORPORATION COMMISSION


(If additional description is necessary, use BACK of this sheet)

Correspondence regarding this well should be addressed to Virginia Drilling Co., Inc. Kansas  
Address 701 Brown Bldg., Wichita 2, Kansas

STATE OF Kansas, COUNTY OF Sedgwick, ss.  
S. A. Murphy (employee of owner) or (owner or operator) of the above-described well,  
being first duly sworn on oath, says: That I have knowledge of the facts, statements, and matters herein contained and the log of the above-described well as filed and that the same are true and correct. So help me God.

(Signature) S. A. Murphy  
701 Brown Bldg., Wichita 2, Kansas (Address)

SUBSCRIBED AND SWORN TO before me this 28th day of November, 1949  
M. A. Hawkins Notary Public

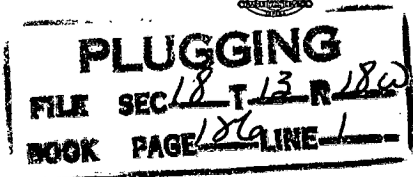

Well: Miller No. 1  
 Location: SE SE NW Section 18-13-18W, Ellis County, Kansas  
 Company: Virginia Drilling Co., Inc. et al  
 Contractor: Virginia Drilling Co., Inc.  
 Commenced: October 26, 1949  
 Completed: November 22, 1949  
 Elevation: 2152  
 Total Depth: 3851

FORMATION	DEPTH	
Lime	0-20	8-5/8" csg. set @ 188'
Shale	20-60	
Shale-shells	60-850	
Sand	850-880	TOPS:
Shale-shells	880-905	Anhydrite 1440
Sand	905-1100	Heebner 3414
Shale-sand	1100-1150	Toronto 3448
Shale-shells	1150-1440	Kansas City 3476
Anhydrite	1440-1485	Conglomerate 3762
Shale-shells	1485-2133	Erosional Arbuckle 3812
Shale-lime	2133-2380	Solid Arbuckle 3821
Lime	2380-2600	
Shale	2600-2725	
Shale-lime	2725-2910	
Lime	2910-2955	
Lime-shale	2955-3110	
Lime	3110-3638	
Iron-cavings	3638-3640	
Lime K.C.	3640-3730	
Lime	3730-3762	
Conglomerate	3762-3821	
Arbuckle Lime	3821-3851	

Now comes S. A. Murphy, who states that he is familiar with the drilling of oil and gas wells and knows of his own knowledge that the Miller No. 1 located in the SE SE NW Section 18-13-18W, Ellis County, Kansas, was drilled to total depth of 3851 feet. Same was plugged and abandoned.

S. A. Murphy

Subscribed and sworn to before me, a Notary Public, this 28<sup>th</sup> day of Nov., 1949.

Mrs. G. Hawkins  
 Notary Public



My commission expires February 5, 1953.

**PLUGGING**  
 FILE SEC 18-T-13-R-18W  
 BOOK PAGE 26 LINE 1