

CARD MUST BE TYPED

State of Kansas
NOTICE OF INTENTION TO DRILL
(see rules on reverse side)

CORRECTION
CARD MUST BE SIGNED
170-86

Starting Date: 1 25 86
month day year

API Number 15- 051-24384 00 00

OPERATOR: License # 5293

S/2. SE. NW. Sec. 22 Twp 11. S. Rge 17. . East
(location) West

Name Helmerich & Payne, Inc.

Address P.O. Box 558

City/State/Zip Garden City, Ks. 67846

Contact Person Millard Lindsay

Phone 316 276-3693

* 3100 Ft North from Southeast Corner of Section
3300 Ft West from Southeast Corner of Section
(Note: Locate well on Section Plat on reverse side)

CONTRACTOR: License #

Name Unknown

City/State

Nearest lease or unit boundary line 660 feet.

County Ellis

Lease Name Beach B Well# 2

Domestic well within 330 feet : yes no

Municipal well within one mile : yes no

Well Drilled For: Well Class: Type Equipment:

Oil Swd Infield Mud Rotary

Gas Inj Pool Ext. Air Rotary

OWWO Expl Wildcat Cable

If OWWO: old well info as follows:

Operator

Well Name

Comp Date Old Total Depth

Projected Total Depth 3500 feet

Projected Formation at TD Arbuckle

Expected Producing Formations Arbuckle and LKC

Depth to Bottom of fresh water 120 feet

Lowest usable water formation Dakota

Depth to Bottom of usable water 650 feet

Surface pipe by Alternate : 1 2

Surface pipe to be set 250 feet

Conductor pipe if any required None feet

Ground surface elevation 1900 ± feet MSI.

This Authorization Expires 7-3-86

Approved By 1-3-86

I certify that we will comply with K.S.A. 55-101, et seq., plus eventually plugging hole to K.C.C. specifications. *Kwas 2970 FSL*


Date 1-9-86 Signature of Operator or Agent *Kew Gedlik* Title Dist. Prod. Engineer

Note: Corrected Intent. Moved location

Must be filed with the K.C.C. five (5) days prior to commencing well
This card void if drilling not started within six (6) months of date received by K.C.C.

Important procedures to follow :

**A Regular Section of Land
1 Mile = 5,280 Ft.**

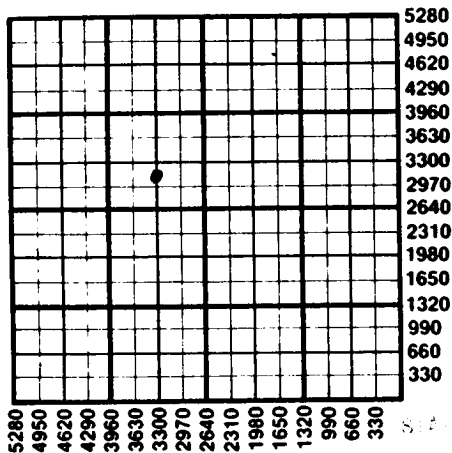

1. Notify District office before setting surface casing.
2. Set surface casing by circulating cement to the top.
3. File completion forms ACO-1 with K.C.C. within 90 days of well completion, following instructions on ACO-1, side 1, and including copies of wireline logs.
4. Notify District office 48 hours prior to old well workover or re-entry.
5. Prior to plugging, prepare a plugging plan, then obtain agreement from the appropriate district office for an approved plugging plan.
6. Submit plugging report (CP-4) to K.C.C. after plugging is completed.
7. Obtain an approved injection docket number before disposing of salt water.
8. Notify K.C.C. within 10 days when injection commences or terminates.
9. If an alternate 2 completion, cement in the production pipe from below any usable water to surface within 120 days of spud date.

State Corporation Commission of Kansas
Conservation Division
200 Colorado Derby Building
Wichita, Kansas 67202
(316) 263-3238

JAN 1 1986

STATE CORPORATION COMMISSION
WICHITA, KANSAS