

CARD MUST BE TYPED

State of Kansas
NOTICE OF INTENTION TO DRILL
(see rules on reverse side)

CORRECTION

CARD MUST BE SIGNED

10-2-85

Starting Date: 10 - 10 - 85
month day year

API Number 15- 051-24,266 (CCC)

OPERATOR: License # 8925

C S/2 NE SE... Sec 22 Twp 11 S, Rge 17. East West
(location)

Name Liberty Operations and Completions, Inc.

Address 308 West Mill

City/State/Zip Plainville, KS 67663

Contact Person David L. Comeau

Phone (913) 434-4686

* 1650..... Ft North from Southeast Corner of Section
* 660..... Ft West from Southeast Corner of Section
(Note: Locate well on Section Plat on reverse side)

CONTRACTOR: License # 5665

Name Pioneer Drilling Co., Inc.

City/State Plainville, Kansas

Nearest lease or unit boundary line 660..... feet.
County Ellis.....

Lease Name Beach E. Well# 9.....

Domestic well within 330 feet: yes no

Municipal well within one mile: yes no

Well Drilled For: Well Class: Type Equipment:

- Oil Swd Infield Mud Rotary
- Gas Inj Pool Ext. Air Rotary
- OWWO Expl Wildcat Cable

Depth to Bottom of fresh water 120..... feet

Lowest usable water formation Dakota.....

Depth to Bottom of usable water 700..... feet

Surface pipe by Alternate: 1 2

Surface pipe to be set 240'..... feet

Conductor pipe if any required N/A..... feet

Ground surface elevation..... feet MSL

This Authorization Expires 12-27-85.....

Approved By 6-27-85.....

If OWWO: old well info as follows:

Operator.....

Well Name.....

Comp Date..... Old Total Depth.....

Projected Total Depth 3800..... feet

Projected Formation at TD Arbuckle.....

Expected Producing Formations Arbuckle.....

I certify that we will comply with K.S.A. 55-101, et seq., plus eventually plugging holes to K.C.C. specifications.

*was: CNESE 1980 FSL


Date 9/30/85 Signature of Operator or Agent

Title Vice Pres

Must be filed with the K.C.C. five (5) days prior to commencing well
This card void if drilling not started within six (6) months of date received by K.C.C.

Important procedures to follow :

**A Regular Section of Land
1 Mile = 5,280 Ft.**

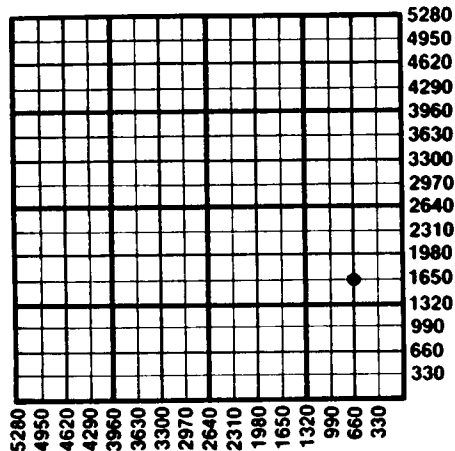

1. Notify District office before setting surface casing.
2. Set surface casing by circulating cement to the top.
3. File completion forms ACO-1 with K.C.C. within 90 days of well completion, following instructions on ACO-1, side 1, and including copies of wireline logs.
4. Notify District office 48 hours prior to old well workover or re-entry.
5. Prior to plugging, prepare a plugging plan, then obtain agreement from the appropriate district office for an approved plugging plan.
6. Submit plugging report (CP-4) to K.C.C. after plugging is completed.
7. Obtain an approved injection docket number before disposing of salt water.
8. Notify K.C.C. within 10 days when injection commences or terminates.
9. If an alternate 2 completion, cement in the production pipe from below any usable water to surface within 120 days of spud date.

RECEIVED
STATE CORPORATION COMMISSION

State Corporation Commission of Kansas
Conservation Division
200 Colorado Derby Building
Wichita, Kansas 67202
(316) 263-3238

OCT 1 1965

CONSERVATION DIVISION
Wichita, Kansas