

CARD MUST BE TYPED

State of Kansas  
**NOTICE OF INTENTION TO DRILL**

CARD MUST BE SIGNED

(see rules on reverse side)

Starting Date: 7 15 85  
month day year

API Number IS- 051-24,244-0600

OPERATOR: License # 8925  
Name Liberty Operations & Completions, Inc.  
Address 308 West Mill  
City/State/Zip Plainville, KS 67663  
Contact Person David L. Comeau  
Phone (913) 434-4686

C E/2 E/2 Sec 22 Twp 11 S, Rge 17  East  
 West  
(location)

2640 Ft North from Southeast Corner of Section  
660 Ft West from Southeast Corner of Section  
(Note: Locate well on Section Plat on reverse side)

CONTRACTOR: License # 5665  
Name Pioneer Drilling Company, Inc.  
City/State Plainville, Kansas

Nearest lease or unit boundary line 660 feet.  
County Ellis

Lease Name Beach E Well# 6

Well Drilled For: Well Class: Type Equipment:  
 Oil  Swd  Infield  Mud Rotary  
 Gas  Inj  Pool Ext.  Air Rotary  
 OWWO  Expl  Wildcat  Cable

Domestic well within 330 feet:  yes  no  
Municipal well within one mile:  yes  no

If OWWO: old well info as follows:

Depth to Bottom of fresh water 120 feet  
Lowest usable water formation Dakota  
Depth to Bottom of usable water 700 feet  
Surface pipe by Alternate: 1  2   
Surface pipe to be set 250 feet  
Conductor pipe if any required N/A feet  
Ground surface elevation \_\_\_\_\_ feet MSI.  
This Authorization Expires 11-29-85

Operator \_\_\_\_\_  
Well Name \_\_\_\_\_  
Comp Date \_\_\_\_\_ Old Total Depth \_\_\_\_\_  
Projected Total Depth 3800 feet  
Projected Formation at TD Arbuckle  
Expected Producing Formations Arbuckle

Approved By 5-29-85 *RC*

I certify that we will comply with K.S.A. 55-101, et seq., plus eventually plugging hole to K.C.C. specifications.

Date 2-5-85 Signature of Operator or Agent *D. Plan*

Title Vice Pres


RECEIVED  
STATE CORPORATION COMMISSION

MAY 29 1985

CONSERVATION DIVISION  
Wichita, Kansas

Must be filed with the K.C.C. five (5) days prior to commencing well  
This card void if drilling not started within six (6) months of date received by K.C.C.

A Regular Section of Land  
1 Mile = 5,280 Ft.

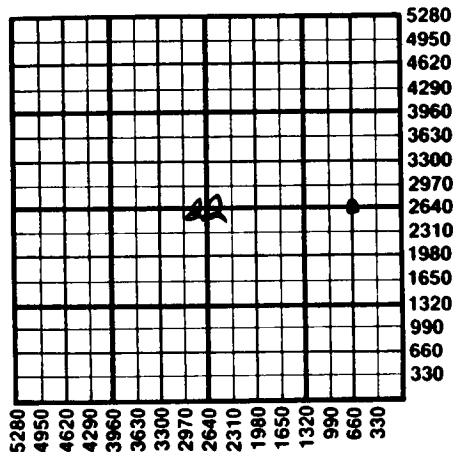

**Important procedures to follow :**

1. Notify District office before setting surface casing.
2. Set surface casing by circulating cement to the top.
3. File completion forms ACO-1 with K.C.C. within 90 days of well completion, following instructions on ACO-1, side 1, and including copies of wireline logs.
4. Notify District office 48 hours prior to old well workover or re-entry.
5. Prior to plugging, prepare a plugging plan, then obtain agreement from the appropriate district office for an approved plugging plan.
6. Submit plugging report (CP-4) to K.C.C. after plugging is completed.
7. Obtain an approved injection docket number before disposing of salt water.
8. Notify K.C.C. within 10 days when injection commences or terminates.
9. If an alternate 2 completion, cement in the production pipe from below any usable water to surface within 120 days of spud date.

State Corporation Commission of Kansas  
Conservation Division  
200 Colorado Derby Building  
Wichita, Kansas 67202  
(316) 263-3238