

CARD MUST BE TYPED

State of Kansas
NOTICE OF INTENTION TO DRILL
(see rules on reverse side)

CORRECTION
CARD MUST BE SIGNED
1-10-86

Starting Date: 2 12 86
month day year

API Number 15- 051-24,386 - ~~00~~ ~~00~~

OPERATOR: License # 5293
Name Helmerich & Payne, Inc.
Address P.O.Box 558
City/State/Zip Garden City, Ks. 67846
Contact Person .. Millard Lindsay
Phone ... 316-276-3693

S/2. NE. SW. Sec 22. Twp 11. S. Rge 17. ... East
(location) West

* 1560' Ft North from Southeast Corner of Section
* 3210' Ft West from Southeast Corner of Section
(Note: Locate well on Section Plat on reverse side)

CONTRACTOR: License #
Name Unknown
City/State

Nearest lease or unit boundary line 570 feet.
County Ellis
Lease Name .. Beach D. Well# 3

Well Drilled For: Well Class: Type Equipment:
 Oil Swd Infield Mud Rotary
 Gas Inj Pool Ext. Air Rotary
 OWWO Expl Wildcat Cable

Domestic well within 330 feet : yes no
Municipal well within one mile : yes no

If OWWO: old well info as follows:

Operator
Well Name
Comp Date Old Total Depth
Projected Total Depth 3500 feet
Projected Formation at TD .. Arbuckle
Expected Producing Formations .. Arbuckle and LKC

Depth to Bottom of fresh water 120 feet
Lowest usable water formation .. Dakota
Depth to Bottom of usable water .. 650 feet
Surface pipe by Alternate : 1 2
Surface pipe to be set 250 feet
Conductor pipe if any required None feet
Ground surface elevation 2000 ± feet MSI.
This Authorization Expires 7-3-86
Approved By 1-3-86

I certify that we will comply with K.S.A. 55-101, et seq., plus eventually plugging hole to K.C.C. specifications.


Date 1-9-86
Signature of Operator or Agent *Ken Gellik*

was: 1650 FSL
3300 FEL
Title Dist. Prod. Engineer....
Form C-1 4/84

Note: Corrected Intent. Moved location

**Must be filed with the K.C.C. five (5) days prior to commencing well
This card void if drilling not started within six (6) months of date received by K.C.C.**

**A Regular Section of Land
1 Mile = 5,280 Ft.**

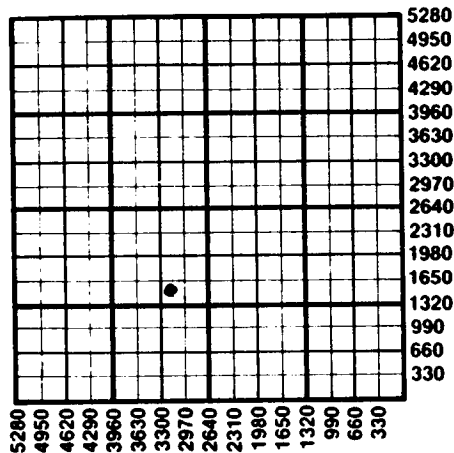

Important procedures to follow:

1. Notify District office before setting surface casing.
2. Set surface casing by circulating cement to the top.
3. File completion forms ACO-1 with K.C.C. within 90 days of well completion, following instructions on ACO-1, side 1, and including copies of wireline logs.
4. Notify District office 48 hours prior to old well workover or re-entry.
5. Prior to plugging, prepare a plugging plan, then obtain agreement from the appropriate district office for an approved plugging plan.
6. Submit plugging report (CP-4) to K.C.C. after plugging is completed.
7. Obtain an approved injection docket number before disposing of salt water.
8. Notify K.C.C. within 10 days when injection commences or terminates.
9. If an alternate 2 completion, cement in the production pipe from below any usable water to surface within 120 days of spud date.

**State Corporation Commission of Kansas
Conservation Division
200 Colorado Derby Building
Wichita, Kansas 67202
(316) 263-3238**

1-10-86