

KANSAS CORPORATION COMMISSION
OIL & GAS CONSERVATION DIVISION

RECEIVED N/OUT ORIG.
KSONA-1 FORM, Form CP-1
March 2010

This Form must be Typed
Form must be Signed
All blanks must be Filled

WELL PLUGGING APPLICATION

Form KSONA-1, Certification of Compliance with the Kansas Surface Owner Notification Act,
MUST be submitted with this form.

OPERATOR: License #: 33637
Name: StepCo Oil Inc.
Address 1: P.O. Box 155
Address 2: _____
City: Ellinwood, KS State: KS Zip: 67526
Contact Person: June Stephens
Phone: (620) 564-2852

API No. 15 - 15-009-24310-0000
If pre 1967, supply original completion date: _____
Spot Description: NE-SE-SE
_____ Sec. 28 Twp. 19 S. R. 11 East West
990' Feet from North / South Line of Section
330' Feet from East / West Line of Section
Footages Calculated from Nearest Outside Section Corner:
 NE NW SE SW
County: Barton
Lease Name: Baird Well #: 2

RECEIVED
DEC 16 2010
KCC WICHITA

Check One: Oil Well Gas Well OG D&A Cathodic Water Supply Well Other: _____
 SWD Permit #: _____ ENHR Permit #: _____ Gas Storage Permit #: _____

Conductor Casing Size: _____ Set at: _____ Cemented with: _____ Sacks
Surface Casing Size: 8 5/8" Set at: 254 Cemented with: 150 Sacks
Production Casing Size: 5 1/2" Set at: 3337 Cemented with: 100 Sacks

List (ALL) Perforations and Bridge Plug Sets:

Open hole 3337' to 3362'

Elevation: 1778 (G.L. / K.B.) T.D.: 3362' PBTD: 3362' Anhydrite Depth: 535'
(Stone Corral Formation)

Condition of Well: Good Poor Junk in Hole Casing Leak at: _____
(Interval)

Proposed Method of Plugging (attach a separate page if additional space is needed):

According to KCC rules.

Is Well Log attached to this application? Yes No Is ACO-1 filed? Yes No ?

If ACO-1 not filed, explain why: Well was drilled in 1988 by Kaneb Expl. Co. unknown if they filed. SteCo purchased this well in 1992.

Plugging of this Well will be done in accordance with K.S.A. 55-101 et. seq. and the Rules and Regulations of the State Corporation Commission

Company Representative authorized to supervise plugging operations: Melvin G Urban
Address: P.O. Box 155 City: Ellinwood State: Ks Zip: 67526
Phone: (620) 793-2712
Plugging Contractor License #: 31529 Name: Mikes Testing & Salvage Inc.
Address 1: P.O. Box 467 Address 2: _____
City: Chase, State: KS Zip: 67524
Phone: (620) 938-2943
Proposed Date of Plugging (if known): Unknown

Payment of the Plugging Fee (K.A.R. 82-3-118) will be guaranteed by Operator or Agent

Date: 12-15-10 Authorized Operator / Agent: June Stephens (Signature)

Mail to: KCC - Conservation Division, 130 S. Market - Room 2078, Wichita, Kansas 67202

RECEIVED
DEC 16 2010
KCC WICHITA

KANSAS CORPORATION COMMISSION
OIL & GAS CONSERVATION DIVISION

REVISED KSONA-1
FORM
Form KSONA-1
July 2010
Form Must Be Typed
Form MUST be Signed
All blanks must be Filled

CERTIFICATION OF COMPLIANCE WITH THE
KANSAS SURFACE OWNER NOTIFICATION ACT

This form must be submitted with all Forms C-1 (Notice of Intent to Drill); CB-1 (Cathodic Protection Borehole Intent); T-1 (Request for Change of Operator Transfer of Injection or Surface Pit Permit); and CP-1 (Well Plugging Application).
Any such form submitted without an accompanying Form KSONA-1 will be returned.

Select the corresponding form being filed: C-1 (Intent) CB-1 (Cathodic Protection Borehole Intent) T-1 (Transfer) CP-1 (Plugging Application)

OPERATOR: License # 33637
Name: StepCo Oil Inc.
Address 1: P.O. Box 155
Address 2: _____
City: Ellinwood State: KS Zip: 67526 + _____
Contact Person: June Stephens
Phone: (620) 564-2852 Fax: (_____) _____
Email Address: _____

Well Location:
NE-SE-SE Sec. 28 Twp. 19 S. R. 11 East West
County: Barton
Lease Name: Baird Well #: 2

If filing a Form T-1 for multiple wells on a lease, enter the legal description of the lease below:

Surface Owner Information:

Name: Dale Knop
Address 1: 1006 E Santa Fe
Address 2: _____
City: Ellinwood, State: KS Zip: 67526 + _____

When filing a Form T-1 involving multiple surface owners, attach an additional sheet listing all of the information to the left for each surface owner. Surface owner information can be found in the records of the register of deeds for the county, and in the real estate property tax records of the county treasurer.

If this form is being submitted with a Form C-1 (Intent) or CB-1 (Cathodic Protection Borehole Intent), you must supply the surface owners and the KCC with a plat showing the predicted locations of lease roads, tank batteries, pipelines, and electrical lines. The locations shown on the plat are preliminary non-binding estimates. The locations may be entered on the Form C-1 plat, Form CB-1 plat, or a separate plat may be submitted.

Select one of the following:

- I certify that, pursuant to the Kansas Surface Owner Notice Act (House Bill 2032), I have provided the following to the surface owner(s) of the land upon which the subject well is or will be located: 1) a copy of the Form C-1, Form CB-1, Form T-1, or Form CP-1 that I am filing in connection with this form; 2) if the form being filed is a Form C-1 or Form CB-1, the plat(s) required by this form; and 3) my operator name, address, phone number, fax, and email address.
- I have not provided this information to the surface owner(s). I acknowledge that, because I have not provided this information, the KCC will be required to send this information to the surface owner(s). To mitigate the additional cost of the KCC performing this task, I acknowledge that I am being charged a \$30.00 handling fee, payable to the KCC, which is enclosed with this form.

If choosing the second option, submit payment of the \$30.00 handling fee with this form. If the fee is not received with this form, the KSONA-1 form and the associated Form C-1, Form CB-1, Form T-1, or Form CP-1 will be returned.

I hereby certify that the statements made herein are true and correct to the best of my knowledge and belief.

Date: 1-21-11 Signature of Operator or Agent: Vinita Q. Stephens Title: Owner
1-21-11 Vinita Q. Stephens

RECEIVED
KANSAS CORPORATION COMMISSION

Mail to: KCC - Conservation Division, 130 S. Market - Room 2078, Wichita, Kansas 67202


JAN 25 2011

CONSERVATION DIVISION
WICHITA, KS

BAKER OIL TOOLS, INC.

SERVING THE WORLD

DATE Dec. 10, 2010 WELL NO. 2 LEASE Baird FIELD _____
Well location NE-SE-SE Sec. 28 TWP 19-R -11 W, Barton Co., KS.

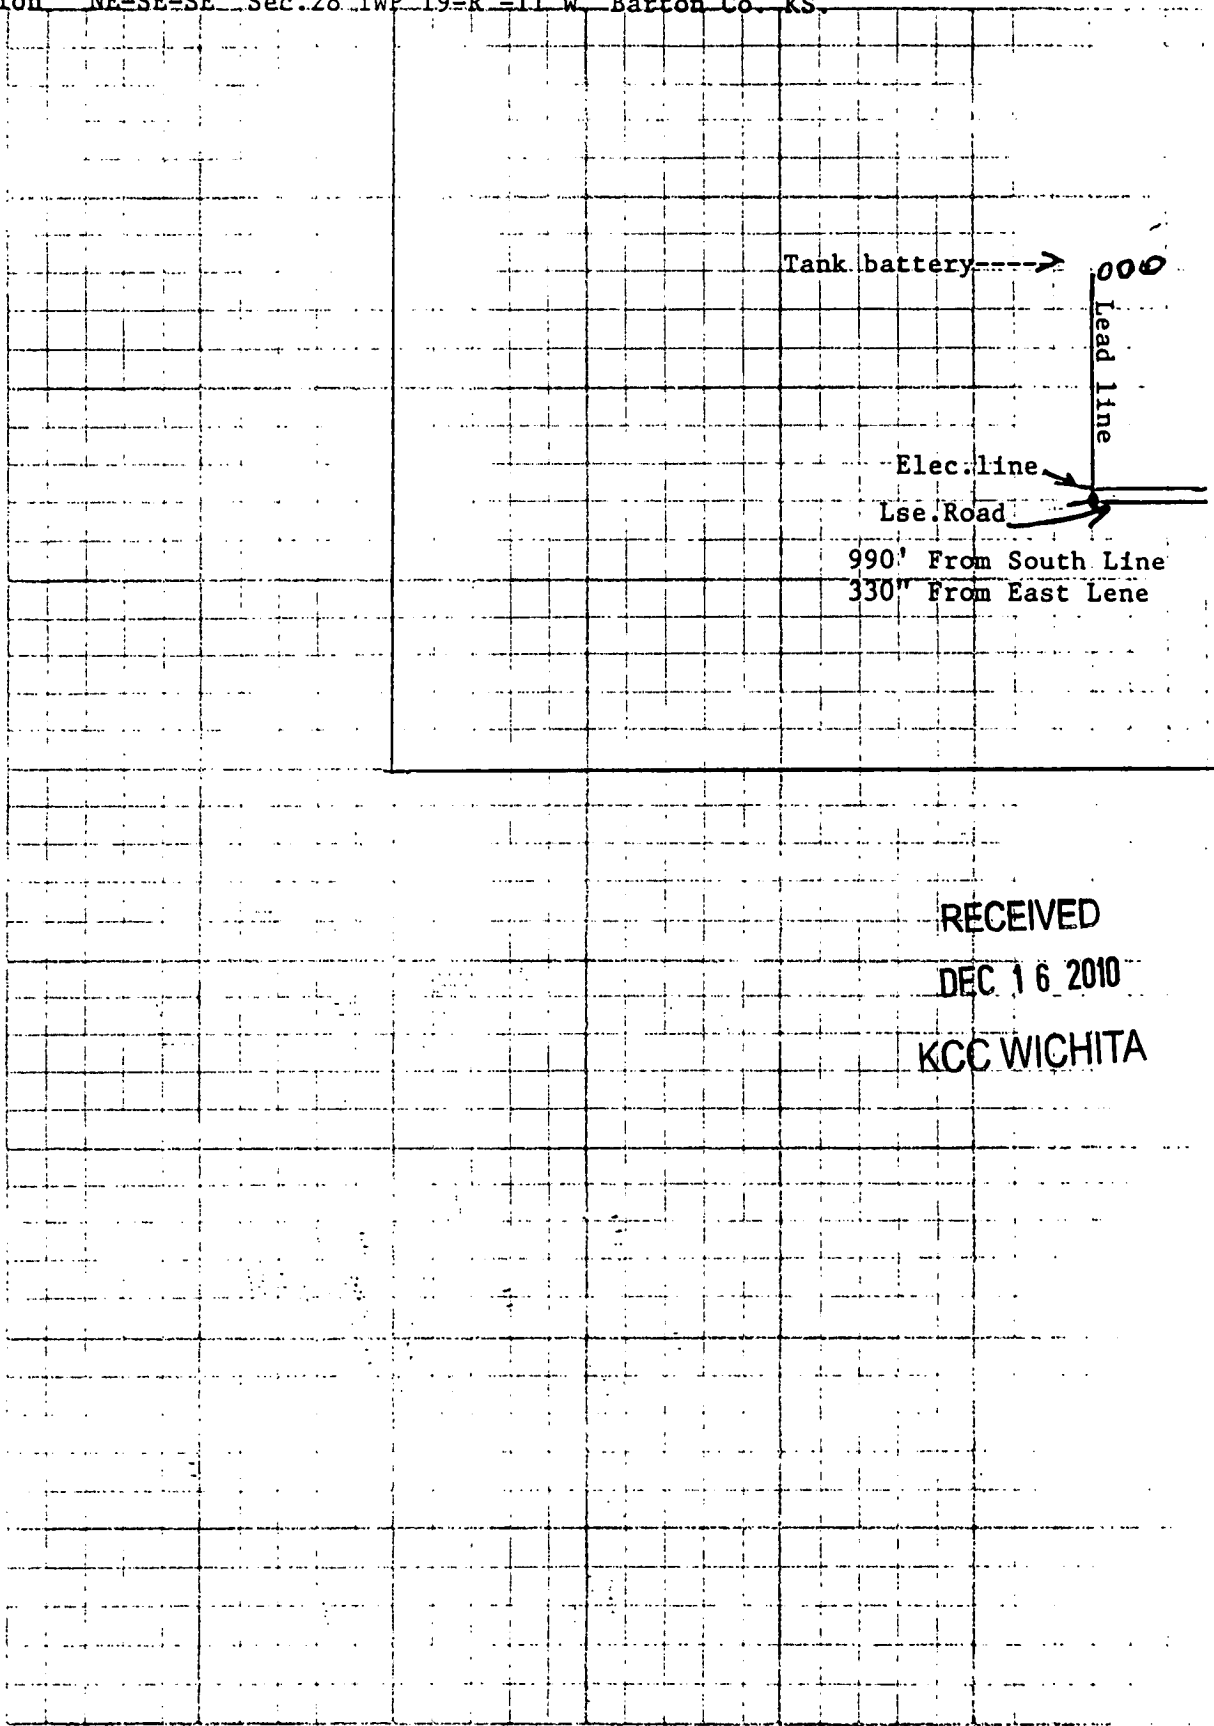

RECEIVED
DEC 16 2010
KCC WICHITA

-  BRIDGE PLUG
-   PACKER
-  CENTRALIZER
-  SCRATCHER
-  BASKET
-  PERFORATION

NOTICE OF RECEIPT OF WELL PLUGGING APPLICATION (CP-1)

STEPCO OIL, INC.
519 W 6TH ST
PO BOX 155
ELLINWOOD, KS 67526-1318

January 26, 2011

Re: BAIRD #2
API 15-009-24310-00-00
28-19S-11W, 990 FSL 330 FEL
BARTON COUNTY, KANSAS


Dear Operator:

This letter is to notify you that the Conservation Division has received your plugging proposal, form CP-1, for the above well and has reviewed the proposal for completeness. The central office will now forward your CP-1 to the district office listed below for review of the proposed plugging method. **Please contact the district office for approval of your proposed plugging method at least five (5) days before plugging the well, pursuant to K.A.R. 82-3-113(b). If a workover pit will be used during the plugging of the well it must be permitted. A CDP-1 form must be filed and approved prior to the use of the pit in accordance with K.A.R. 82-3-600.**

The Conservation Division's review of form CP-1, either in the central or district office, does not include an inquiry into well ownership or the filing operator's legal right to plug the well. This notice in no way constitutes authorization to plug the above well by persons not having legal rights of ownership or interest in the well.

This notice is void after July 25, 2011. The CP-1 filing does not bring the above well into compliance with K.A.R. 82-3-111 with regard to the Commission's temporary abandonment requirements.

Sincerely

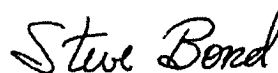A handwritten signature in cursive script that reads "Steve Bond".

Steve Bond
Production Department Supervisor

District: #4
2301 E. 13th
Hays, KS 67601
(785) 625-0550