

STATE CORPORATION COMMISSION OF KANSAS
OIL & GAS CONSERVATION DIVISION

WELL COMPLETION OR RECOMPLETION FORM
ACO-1 WELL HISTORY

DESCRIPTION OF WELL AND LEASE

Operator: License # 9459
Name C.F. Kimmell
Address 1716 Milam Building
San Antonio
City/State/Zip Texas 78205

Shut in
Purchaser

Operator Contact Person C.E. Kimmell
Phone (512) 223-4452

Contractor: License # 5426
Name Dunne-Gardner Petroleum, Inc.

Wellsite Geologist Edmund G. Lorenz
Phone 683-2832

Designate Type of Completion
 New Well Re-Entry Workover
 Oil SWD Temp Abd
 Gas Inj Delayed Comp.
 Dry Other (Core, Water Supply etc.)

If OWWO: old well info as follows:
Operator
Well Name
Comp. Date Old Total Depth

WELL HISTORY

Drilling Method:
 Mud Rotary Air Rotary Cable
May 2, 1984 May 16, 1984 June 1, 1984
Spud Date Date Reached TD Completion Date
5360 4134
Total Depth PBDT

Amount of Surface Pipe Set and Cemented at 315 feet
Multiple Stage Cementing Collar Used? Yes No
If yes, show depth set feet
If alternate 2 completion, cement circulated from feet depth to w/ SX cmt

API No. 15-007-21,791

County Barber

Sec. 24 Twp. 34 Rge. 11 East West


1787 Ft North from Southeast Corner of Section
4813 Ft West from Southeast Corner of Section
(Note: Locate well in section plat below)

Lease Name R.V. Nelson Well # 1

Field Name MAYBERRY NO

Producing Formation Stalnaker

Elevation: Ground 1349 KB 1358
Section Plat

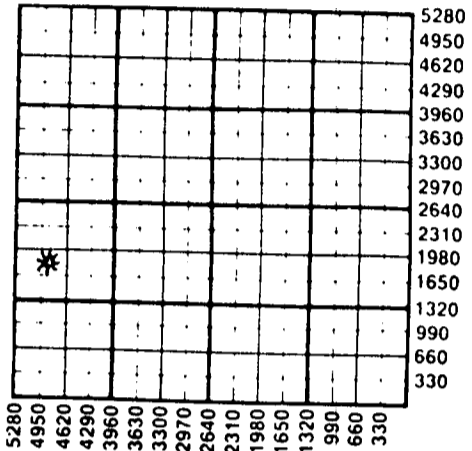

WATER SUPPLY INFORMATION

Disposition of Produced Water: Disposal Repressuring
Docket #

Questions on this portion of the ACO-1 call:
Water Resources Board (913) 296-3717

Source of Water:
Division of Water Resources Permit #
 Groundwater (Well) Ft North from Southeast Corner
Ft West from Southeast Corner of
Sec Twp Rge East West
 Surface Water (Stream, pond etc) 1900 Ft North from Southeast Corner
4620 Ft West from Southeast Corner
Sec 24 Twp 34 Rge 11 East West
 Other (explain) (purchased from city, R.W.D. #)

INSTRUCTIONS: This form shall be completed in duplicate and filed with the Kansas Corporation Commission, 200 Colorado Derby Building, Wichita, Kansas 67202, within 90 days after completion or recompletion of any well. Rule 82-3-130 and 82-3-107 apply.
Information on side two of this form will be held confidential for a period of 12 months if requested in writing and submitted with the form. See rule 82-3-107 for confidentiality in excess of 12 months.
One copy of all wireline logs and drillers time log shall be attached with this form. Submit CP-4 form with all plugged wells. Submit CP-111 form with all temporarily abandoned wells.

All requirements of the statutes, rules and regulations promulgated to regulate the oil and gas industry have been fully complied with and the statements herein are complete and correct to the best of my knowledge.

Signature [Signature] Title Owner/Operator Date 8-30-84

Subscribed and sworn to before me this 30th day of August, 1984.
Notary Public [Signature] Suzanne G. Eck
Date Commission Expires July 23, 1988

SUZANNE G. ECK
NOTARY PUBLIC
STATE OF KANSAS
My Appt. exp. 7-23-88

K.C.C. OFFICE USE ONLY
 Letter of Confidentiality Attached
 Wireline Log Received
 Drillers Timelog Received
Distribution
 KCC SWD/Rep NGPA
 KGS Plug Other
(Specify)

Sec. 24 Twp. 34 Rge. 11