

Give All Information Completely
Make Required Affidavit
Mail or Deliver Report to:
Conservation Division
State Corporation Commission
Wichita, Kansas

WELL PLUGGING RECORD

Hamilton County, Sec. 7 Twp. 25S Rge. 42W (E) (W)

Location as "NE/CNW/SW" or footage from lines C SW/4 NE/2

Lease Owner Thomas K. Gaughan

Lease Name Scholz Well No. 1

Office Address 2332 S. Delaware Place - Tulsa, Okla.

Character of Well (completed as Oil, Gas or Dry Hole) Dry Hole

Date well completed December 27, 1967 19

Application for plugging filed 19

Application for plugging approved 19


Plugging commenced December 28, 1967 19

Plugging completed December 28, 1967 19

Reason for abandonment of well or producing formation Dry Hole

If a producing well is abandoned, date of last production 19

Was permission obtained from the Conservation Division or its agents before plugging was commenced? Yes

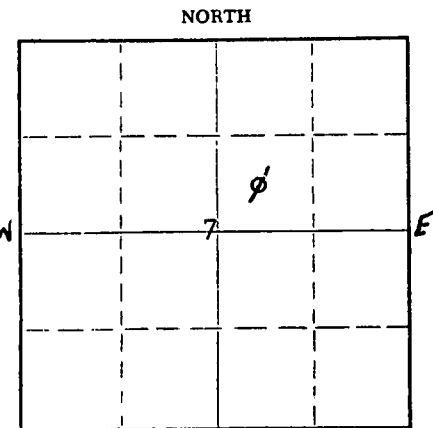

Locate well correctly on above Section Plat

Name of Conservation Agent who supervised plugging of this well Edgar Eves

Producing formation Council Grove Depth to top 3043' Bottom 3146' Total Depth of Well 3280 Feet

Show depth and thickness of all water, oil and gas formations.

OIL, GAS OR WATER RECORDS

CASING RECORD

FORMATION	CONTENT	FROM	TO	SIZE	PUT IN	PULLED OUT
	Rock & Red Bed	0'	599'	8-5/8"	599'	0

Describe in detail the manner in which the well was plugged, indicating where the mud fluid was placed and the method or methods used in introducing it into the hole. If cement or other plugs were used, state the character of same and depth placed, from feet to feet for each plug set.

35 sx. cement at 600' (8")
15 sx. cement at 45' to top of casing

RECEIVED
STATE CORPORATION COMMISSION
FEB 9 - 1968
CONSERVATION DIVISION
Wichita, Kansas

(If additional description is necessary, use BACK of this sheet)
Name of Plugging Contractor Rine Drilling Company, Inc.
Address Suite 600 - 300 W. Douglas - Wichita, Kansas 67202

STATE OF KANSAS, COUNTY OF SEDGWICK
R. M. Green Contractor, ss.
(employee of Rine Drilling Company, Inc.) of the above-described well, being first duly sworn on oath, says: That I have knowledge of the facts, statements, and matters herein contained and the log of the above-described well as filed and that the same are true and correct. So help me God.
(Signature) R. M. Green
Suite 600 - 300 West Douglas - Wichita (Address)

SUBSCRIBED AND SWORN TO before me this 8th day of February, 1968
Bette J. Edwards
Bette J. Edwards Notary Public.

My commission expires June 8, 1970



SW NE
SECTION 7-25S-42W
HAMILTON COUNTY, KANSAS

SCHOLZ WELL NO. 1

CONTRACTOR: RINE DRILLING COMPANY, INC.

STARTED: DECEMBER 18, 1967

COMPLETED: DECEMBER 28, 1967

L O G

Big Rock	0'	-	510'
Rock & Red Bed	510'	-	603'
Red Bed, Gypsum & Shale	603'	-	1135'
Red Bed	1135'	-	1805'
Red Bed & Shale	1805'	-	2150'
Shale & Lime	2150'	-	2340'
Red Bed	2340'	-	2685'
Shale	2685'	-	3001'
Lime & Shale	3001'	-	3250'

Totco - 1/4° @ 160'; 1/4° @ 498'
Ran 18 jts. 8 5/8 csg. to 603'. Cem.
w/275 sx. nozmix 2% cc & 150 sx. cm
3% cc

Totco - 3/4° @ 2340'
Totco - 3/4° @ 2487'


RECEIVED
STATE CORPORATION COMMISSION
FEB 9 - 1968
CONSERVATION DIVISION
Wichita, Kansas

STATE OF KANSAS)
COUNTY OF SEDGWICK) ss

I, R. M. Green, do hereby certify that the above is a true and accurate log of the Scholz Well No. 1, located SW of NE of Section 7-25S-42W, Hamilton County, Kansas.


R. M. Green, Secretary-Treasurer

Subscribed and sworn to before me this 4th day of January, 1968.


Sam R. Clift, Notary Public

My Commission Expires: 9/4/68