


WELL PLUGGING RECORD

Give All Information Completely  
Make Required Affidavit  
Mail or Deliver Report to:  
Conservation Division  
State Corporation Commission  
212 No. Market  
Wichita, Kansas

Chautauqua County, Sec. 29 Twp. 33S Rge. 10 (E) (W)

Location as "NE/CNW/SW" or footage from lines NE SE NE  
Lease Owner John M. Denman Oil Co.  
Lease Name Brown Well No. 4  
Office Address PO Box 36 Sedan, Kansas 67361  
Character of Well (completed as Oil, Gas or Dry Hole) oil  
Date well completed unk 19\_\_  
Application for plugging filed 8-3-72 19\_\_  
Application for plugging approved 8-3-72 19\_\_  
Plugging commenced 8-21-72 19\_\_  
Plugging completed 8-22-72 19\_\_  
Reason for abandonment of well or producing formation No oil

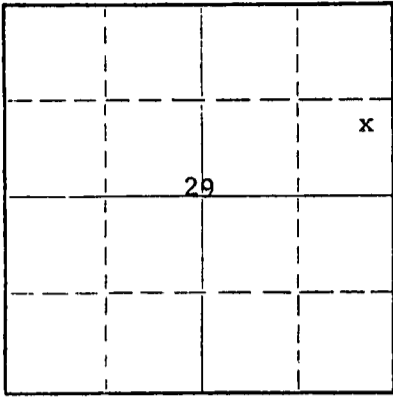

Locate well correctly on above Section Plat

If a producing well is abandoned, date of last production Nov. 1970 19\_\_  
Was permission obtained from the Conservation Division or its agents before plugging was commenced? yes

Name of Conservation Agent who supervised plugging of this well Bert Wilcox  
Producing formation \_\_\_\_\_ Depth to top \_\_\_\_\_ Bottom \_\_\_\_\_ Total Depth of Well 1585 Feet  
Show depth and thickness of all water, oil and gas formations.

OIL, GAS OR WATER RECORDS

CASING RECORD

FORMATION	CONTENT	FROM	TO	SIZE	PUT IN	PULLED OUT
				4 1/2"	unk	1064'

Describe in detail the manner in which the well was plugged, indicating where the mud fluid was placed and the method or methods used in introducing it into the hole. If cement or other plugs were used, state the character of same and depth placed, from \_\_\_\_\_ feet to \_\_\_\_\_ feet for each plug set.

3 sacks cement on bottom  
Rock bridge & 10 sacks cement at 330"  
Rock bridge & 3 sacks cement at 30'  
Soil to surface

RECEIVED  
STATE CORPORATION COMMISSION  
AUG 28 1972  
08-28-72  
CONSERVATION DIVISION  
Wichita, Kansas


(If additional description is necessary, use BACK of this sheet)  
Name of Plugging Contractor Flom Drilling Co. SEDAN WELL SERVICES # 619  
Address Sedan, Kansas

STATE OF Kansas, COUNTY OF Chautauqua, ss.  
Paul Simpson (employee of owner) or (owner or operator) of the above-described

well, being first duly sworn on oath, says: That I have knowledge of the facts, statements, and matters herein contained and the log of the above-described well as filed and that the same are true and correct. So help me God.

(Signature) Paul Simpson John M. Denman Oil Co.  
Paul Simpson, Partner  
Sedan, Kansas (Address)

Subscribed and sworn to before me this 25 day of Aug., 1972

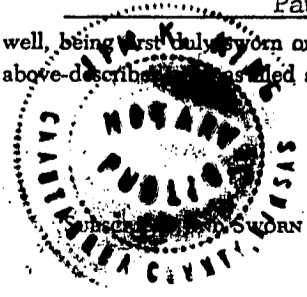

My commission expires 9-26-72  
Jim K. King Notary Public.