


WELL PLUGGING RECORD

Give All Information Completely  
Make Required Affidavit  
Mail or Deliver Report to:  
Conservation Division  
State Corporation Commission  
211 No. Broadway  
Wichita, Kansas

Hamilton County. Sec. 30 Twp. 22 Rge. 41W (E) (W)  
Location as "NE/CNW/SW" or footage from lines c-ne 1/4

Lease Owner Livingston Oil Co.  
Lease Name Unit 3021 Well No. 1  
Office Address Box 1797, Tulsa, Oklahoma  
Character of Well (completed as Oil, Gas or Dry Hole) Dry Hole  
Date well completed June 1963 19\_\_  
Application for plugging filed 11-28 19 66  
Application for plugging approved 12- 1 19 66  
Plugging commenced 2 - 21 19 67  
Plugging completed 2 - 22 19 67  
Reason for abandonment of well or producing formation \_\_\_\_\_

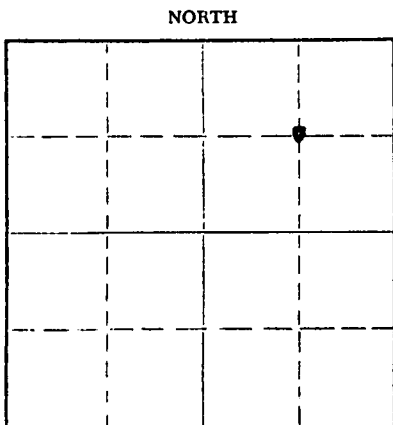

Locate well correctly on above  
Section Plat

If a producing well is abandoned, date of last production \_\_\_\_\_ 19\_\_  
Was permission obtained from the Conservation Division or its agents before plugging was commenced? Yes

Name of Conservation Agent who supervised plugging of this well Ed Eves  
Producing formation \_\_\_\_\_ Depth to top \_\_\_\_\_ Bottom \_\_\_\_\_ Total Depth of Well 2659 Feet  
Show depth and thickness of all water, oil and gas formations.

OIL, GAS OR WATER RECORDS

CASING RECORD

FORMATION	CONTENT	FROM	TO	SIZE	PUT IN	PULLED OUT
				8 5/8	107	0
				4 1/2	2659	2046

Describe in detail the manner in which the well was plugged, indicating where the mud fluid was placed and the method or methods used in introducing it into the hole. If cement or other plugs were used, state the character of same and depth placed, from \_\_\_\_\_ feet to \_\_\_\_\_ feet for each plug set.

Mix 10 sacks cement with hulls to plug off perforations. Stop plug at 2480 feet. Shoot pipe loose at 2046 and pull same to 600 feet. Spot 30 sacks cement at 600 to 500 feet. Mud to 80 feet and plug and 20 sacks cement at 80 feet to 0 feet.

RECEIVED  
MAR 18 1967  
03-13-67  
CONSERVATION DIVISION  
WICHITA, KANSAS

(If additional description is necessary, use BACK of this sheet)  
Name of Plugging Contractor Sargent's Casing Pulling Service  
Address Box 506 Liberal, Kansas

STATE OF Oklahoma COUNTY OF Tulsa, ss.  
Boyd Phillips (employee of owner) or (~~owner~~) of the above-described

well, being first duly sworn on oath, says: That I have knowledge of the facts, statements, and matters herein contained and the log of the above-described well as filed and that the same are true and correct. So help me God.

(Signature) Boyd Phillips

(Address) \_\_\_\_\_

SUBSCRIBED AND SWORN TO before me this 10th day of March, 1967

My Commission Expires AUGUST 10, 1969  
My commission expires \_\_\_\_\_  
Margaret Heath Notary Public.