

STATE OF KANSAS
STATE CORPORATION COMMISSION

WELL PLUGGING RECORD

OR
FORMATION PLUGGING RECORD


Strike out upper line when reporting plugging off formations.

Give All Information Completely
Make Required Affidavit
Mail or Deliver Report to:
Conservation Division
State Corporation Commission
800 Bitting Building
Wichita, Kansas

Scott County. Sec. 16 Twp. 19S Rge. (E) 34 (W)

Location as "NE $\frac{1}{4}$ NW $\frac{1}{4}$ SW $\frac{1}{4}$ " or footage from lines SW $\frac{1}{4}$ SW $\frac{1}{4}$ NE $\frac{1}{4}$
Lease Owner Gulf Oil Corporation
Lease Name Robinson Fee Well No. 1
Office Address Box 661, Tulsa, Oklahoma
Character of Well (completed as Oil, Gas or Dry Hole) Dry hole
Date well completed September 18 1946
Application for plugging filed September 26 1946
Application for plugging approved September 28 1946
Plugging commenced September 30 1946
Plugging completed October 1 1946
Reason for abandonment of well or producing formation Dry hole

NORTH

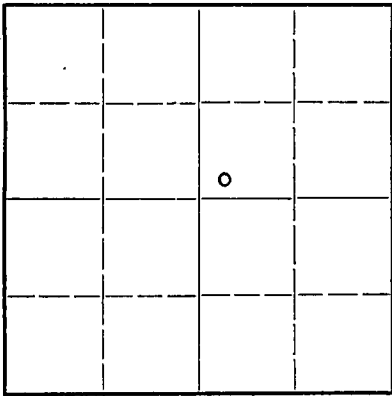

Locate well correctly on above Section Plat

If a producing well is abandoned, date of last production 19
Was permission obtained from the Conservation Division or its agents before plugging was commenced? Yes

Name of Conservation Agent who supervised plugging of this well H. W. Kerr
Producing formation Depth to top Bottom Total Depth of Well 3142 Feet
Show depth and thickness of all water, oil and gas formations.

OIL, GAS OR WATER RECORDS


CASING RECORD

Formation	Content	From	To	Size	Put In	Pulled Out
Florence Flint	Dry	2872'	2920'	8-5/8"	883'	0
				5-1/2"	3130'	2100'

Describe in detail the manner in which the well was plugged, indicating where the mud fluid was placed and the method or methods used in introducing it into the hole. If cement or other plugs were used, state the character of same and depth placed, from feet to feet for each plug set.

Lane-Wells plugs and cement from 3142' to 2799'
Filled with mud from 2799' to 2830'
Dumped 3 sacks cement at 2830'
Filled with mud to 250'
Dumped 15 sacks cement at 250'
Filled with mud to base of cellar
Capped with 10 sacks cement

FILE NO. 16 19 34
BOOK PAGE 76 LINE 20

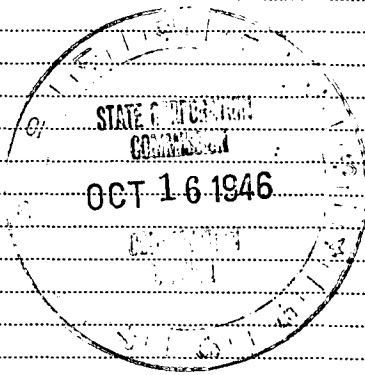

RWD
10-16-46

(If additional description is necessary, use BACK of this sheet)

Correspondence regarding this well should be addressed to A. M. Bell Jr.
Address Box 661, Tulsa, Oklahoma

STATE OF Kansas, COUNTY OF Rice, ss.

H. H. Wright (employee of owner) of the above-described well, being first duly sworn on oath, says: That I have knowledge of the facts, statements, and matters herein contained and the log of the above-described well as filed and that the same are true and correct. So help me God.

(Signature) H. H. Wright
(Address)

SUBSCRIBED AND SWORN to before me this 8th day of October, 1946

My commission expires May 18, 1950
Virgil C. Stevenson Notary Public

WELL NO. **1** LEASE **Robinson Fee** COMPANY **Gulf Oil Corporation** A.F.E. **2978**

DATE—DRILLING BEGAN **8-16-48** WELL COMPLETED **9-18-48** FIRST PRODUCTION **—**

SAND RECORD TOTAL DEPTH **2799'**
P. B. From **3142'**

INITIAL PRODUCTION **DRY HOLE**

CASING RECORD

SIZE	WEIGHT	THD.	CLASS	MAKE	SET AT DEPTH	SACKS CEMENT	LBS. CAL. CNLO.	PULLED	LEFT IN
8-3/4"	24	SR	A	L. V.	895'	310			895'
8-1/2"	14	SR	**	Galv.	3130'	280		2100'	1030'

S- 16 T- 108 R- 34W

SW					
SE					
NE					
Scott					
County					
Tract					

ELEVATION — **3045'**

*14 jts. Class A ; 27 jts. Class B
*Perforated 2799 - 40; 2759 - 66; 2771 - 94.

ACIDIZED: 9-11-48 with 1000 gallons.
9-16-48 with 1000 gallons.

*2 Pcs. 2877-915
" 2786-92
Slight Por + Seal x*

FORMATION RECORD

	From	To
Sand and shale	0	200
Shale and shells		610
Lime, sandy		895
Shale		1150
Red bed and shale		1475
Shale and red bed		1900
Red bed, shale and shells		2115
Red bed		2200
Red rock and lime		2410
Shale and shells		2799
Shale (TOTAL DEPTH)		3142 - 3145

FILED 16-19-34W
BOX 76 20

ED
10-7-48

RWD
10-12-48