


WELL PLUGGING RECORD

Give All Information Completely
 Make Required Affidavit

COUNTY Ellis SEC. 6 TWP. 13S RGE. 18 X/W
 Location as in quarters or footage from lines:
NW NW SE

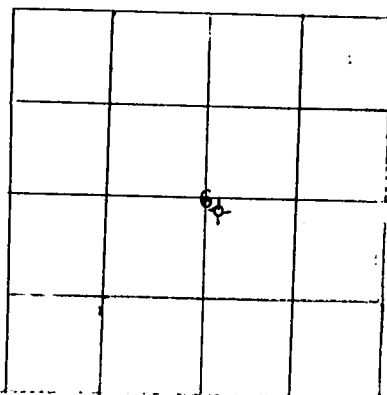

Locate Well
 correctly on above
 Section Platt.

Lease Owner Gear Petroleum Company, Inc.
 Lease Name Schmeidler Well No. 1-6
 Office Address 300 Sutton Place, Wichita, KS 67202
 Character of Well (Completed as Oil, Gas or Dry Hole): D&A
 Date Well Completed October 23, 1982
 Application for plugging filed October 22, 1982
 Plugging commenced October 23, 1982
 Plugging completed October 23, 1982
 Reason for abandonment of well or producing formation D&A

Was permission obtained from the Conservation Division or it's
 Agent's before plugging was commenced? yes

Name of Conservation Agent who supervised plugging of this well Carl Goodrow
 Producing formation _____ Depth to top _____ bottom _____ T.D. 3840'

Show depth and thickness of all water, oil and gas formations.

OIL, GAS OR WATER RECORDS

Casing Record

Formation	Content	From	To	Size	Put in	Pulled Out
				8-5/8"	238'	-0-

Describe in detail the manner in which the well was plugged, indicating where the mud
 fluid was placed and the method or methods used in introducing it into the hold. If cement
 or other plugs were used, state the character of same and depth placed, from _____ feet
 to _____ feet for each plug set.

Hole Plugged:
 1st @ 3840' w/20 sx
 2nd @ 880' w/80 sx
 3rd @ 240' w/20 sx
 bridge @ 40' w/20 sx
 10 sx in rathole
 Cmt w/150 sx of poz, 6% Gel., 3% C.C.

(If additional description is necessary, use BACK of this sheet)
 Name of Plugging Contractor Allied Cementing Company
Box 31, 332 W. Wichita, Russell, KS 67202

STATE OF Kansas COUNTY OF Sedgwick, ss.
Jim Thatcher, Drilling & Production Mgr (employee of owner) or (owner or operator) of the
 above-described well, being first duly sworn on oath, says: That I have knowledge of the
 facts, statements, and matters herein contained and the log of the above-described well as
 filed and that the same are true and correct. So help me God.

(Signature) [Signature]
308 Sutton Place, Wichita, KS
 (Address) 67202

SUBSCRIBED AND SWORN TO before me this 5th day of November, 1982

My Commission expires: April 1, 1986

RECEIVED [Signature]
 STATE CORPORATION COMMISSION
 11-05-1982
 Notary Public.

NOV 08 1982

CONSERVATION DIVISION
 Wichita, Kansas
 HELEN L. COYER
 NOTARY PUBLIC
 STATE OF KANSAS
 My Appt. Exp. 4-1-86