


WELL PLUGGING RECORD

Give All Information Completely
Make Required Affidavit
Mail or Deliver Report to:
Conservation Division
State Corporation Commission
211 No. Broadway
Wichita, Kansas

NORTH

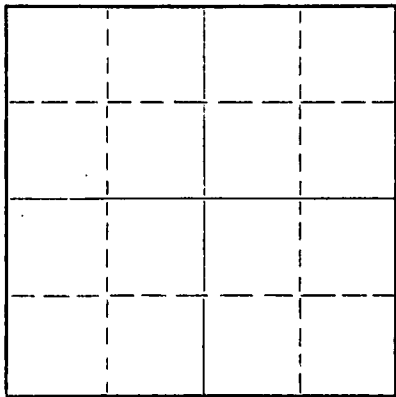

Locate well correctly on above
Section Plat

Ellis County. Sec. 7 Twp. 13S Rge. 18 (X) (W)
Location as "NE/CNW/SW" or footage from lines NW SW NE
Lease Owner Frontier Oil Company
Lease Name Farmers State Bank Well No. #1
Office Address 536 Pet. bldg. Wichita, Kansas
Character of Well (completed as Oil, Gas or Dry Hole) Dry Hole
Date well completed 7/13/56 19
Application for plugging filed 7/12/56 19
Application for plugging approved 7/12/56 19
Plugging commenced 7/13/56 19
Plugging completed 7/13/56 19
Reason for abandonment of well or producing formation Dry Hole

If a producing well is abandoned, date of last production _____ 19
Was permission obtained from the Conservation Division or its agents before plugging was commenced? Yes

Name of Conservation Agent who supervised plugging of this well Eldon Petty
Producing formation _____ Depth to top _____ Bottom _____ Total Depth of Well 3835 Feet
Show depth and thickness of all water, oil and gas formations.

OIL, GAS OR WATER RECORDS

CASING RECORD

FORMATION	CONTENT	FROM	TO	SIZE	PUT IN	PULLED OUT
				8 5/8"	348	None

Describe in detail the manner in which the well was plugged, indicating where the mud fluid was placed and the method or methods used in introducing it into the hole. If cement or other plugs were used, state the character of same and depth placed, from _____ feet to _____ feet for each plug set.

PLUGGING REPORT

Filled from 3835' to 330' with heavy mud. Set wood plug at 330', using hulls and 15 sacks cement through drill pipe up to 300'. Filled with heavy mud from 300' to 30'. Set wood plug, using hulls and 10 sacks cement up to cellar - 0'. Job completed 3:00 PM 7/13/56

(If additional description is necessary, use BACK of this sheet)

Name of Plugging Contractor Sierra Petroleum Co., Inc.
Address 420 West Douglas, Wichita, Kansas

STATE OF KANSAS, COUNTY OF RUSSELL, ss.
C. I. Honaker (employee of owner) or (owner or operator) of the above-described well, being first duly sworn on oath, says: That I have knowledge of the facts, statements, and matters herein contained and the log of the above-described well as filed and that the same are true and correct. So help me God.

(Signature) C. I. Honaker

(Address)

SUBSCRIBED AND SWORN TO before me this 16th day of July, 1956

Margie Casper

Notary Public.

My commission expires 1-30-57

PLUGGING
FILE SEC 7 T 13 R 18W
BOOK PAGE 80 LINE 22

07-18-1956
STATE CORPORATION COMMISSION
Wichita, Kansas

Frontier Oil Company
Farmers State Bank

NW SW NE 7-13S-18W
Ellis County, Kansas

Sierra Petroleum Co., Inc. (Contr.)

Elev: 2170' DF

Total Depth: 3835'

Comm: 6/28/56

Comp: 7/13/56

Casing:

8 5/8" @ 348'

Cement:

175 sacks of Bulk

FORMATION

DEPTH

Surface Clay Post Rock	60
Sand - shale	150
Shale - shells	550
Sand - shale	600
Shale - shells	920
Shale - sand	1145
Red Bed	1330
Red Bed Shale	1495
Anhydrite	1585
Shale - shells	1860
Shale - salt	1990
Shale - lime	3392
Lime	3795
Arbuckle	3835

TOPS: Anhydrite
Arbuckle

1495
3805

STATE OF KANSAS)
) ss:
COUNTY OF RUSSELL)

I hereby certify that the above information is true and correct to the best of my knowledge.

C. P. Honaker

Subscribed and sworn to before me this 16th day of July, 1956

Margie Cooper
Notary Public

My commission expires: 1-30-57

PLUGGING
FILE SEC 7 T. 13 R. 18W
BOOK PAGE 80 LINE 22

07-18-1956