

15-051-30836-00-00

WELL PLUGGING RECORD

Give All Information Completely
Make Required Affidavit
Mail or Deliver Report to:
Conservation Division
State Corporation Commission
800 Bitting Building
Wichita, Kansas

ELLIS

County. Sec. 7 Twp. 13 Rge. 18 (W)

Location as "NE/CNW $\frac{1}{4}$ SW $\frac{1}{4}$ " or footage from lines NW NW NW

Lease Owner Pickrell Drilling Company, Inc. et al

Lease Name Rupp Well No. 1

Office Address 705 4th Natl Bank Bldg., Wichita 2, Kansas

Character of Well (completed as Oil, Gas or Dry Hole) D & A

Date well completed 5/11 1950

Application for plugging filed 5/11 5 19 50

Application for plugging approved 5/11 19 50


Plugging commenced 5/12 19 50

Plugging completed 5/12 19 50

Reason for abandonment of well or producing formation D & A

If a producing well is abandoned, date of last production 19

Was permission obtained from the Conservation Division or its agents before plugging was commenced? Yes

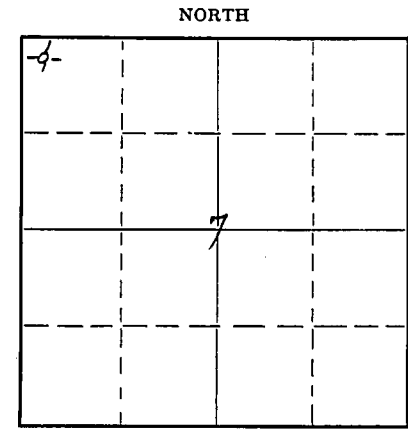

Locate well correctly on above Section Plat

Name of Conservation Agent who supervised plugging of this well Eldon Petty

Producing formation Depth to top Bottom Total Depth of Well 3840 Feet

Show depth and thickness of all water, oil and gas formations.

OIL, GAS OR WATER RECORDS

CASING RECORD

Formation	Content	From	To	Size	Put In	Pulled Out
				8 5/8"	217'	None
				No Oil string run.		

Describe in detail the manner in which the well was plugged, indicating where the mud fluid was placed and the method or methods used in introducing it into the hole. If cement or other plugs were used, state the character of same and depth placed, from feet to feet for each plug set.

Filled hole with heavy mud to 200' - Set bridge & cemented with 15 sax.
Filled with heavy mud to 35', cemented with 10 sax to bottom of cellar.

(If additional description is necessary, use BACK of this sheet)

Correspondence regarding this well should be addressed to Pickrell Drilling Company, Inc. 1950
Address 705 Fourth National Bank Bldg., Wichita 2, Kansas.

RECEIVED
MAY 21 1950
CITY OF WICHITA, KANSAS

STATE OF Kansas, COUNTY OF Sedgwick, ss. C. W. Sebitts (employee of owner) or (owner or operator) of the above-described well,

being first duly sworn on oath, says: That I have knowledge of the facts, statements, and matters herein contained and the log of the above-described well as filed and that the same are true and correct. So help me God.

(Signature) [Signature]

705 Fourth National Bank Bldg., Wichita 2, Kansas (Address)

SUBSCRIBED AND SWORN TO before me this 16th day of May, 1950.

[Signature] Notary Public.

My commission expires January 28, 1953.

FILED
FILE SEC-7-T-13-R-18
BOOK PAGE 5 LINE 25

COMPANY: PICKRELL DRILLING COMPANY, ET AL Rotary Drilling Commenced: 5-3-50
 Wichita, Kansas Rotary Drilling Completed: 5-12-50

LOCATION: RUFF #1
 NW NW NW Sec. 7-12-18W
 Ellis County, Kansas

CONTRACTOR: PICKRELL DRILLING COMPANY, INC.
 Wichita, Kansas

CASING RECORD: 217' (7 jts.) 8 5/8" 2 1/4" ann. casing set at 217' in a 7 7/8" hole,
 cemented with 125 sacks cement.

Drilled 7 7/8" hole from 217' to 3840' T.D. No Oil String Run.

LOG

(Figures indicate bottom formation - measurements from top rotary bushing.)

Cellar	5
Shale	218
Shale & Sand	500
Shale, Shells & Sand	1340
Shale	1470
Line Anhydrite	1510
Shale	2100
Line	2410
Shale & Line	2880
Shale	3015
Shale & Line	3260
Line	3840 Rotary T.D.

Circulate for samples at 3583'
 " " " " 3724'
 " " " " 3820'
 " " " " 3840'

Slope test at 200' - 0° off.
 " " " 2900' - 0° off.
 S.L.M. at 3560' - O.K.

Fill hole with heavy mud to 200'.
 Set bridge and cemented with 15 sack cement.
 Fill with heavy mud to 39'. Cemented
 with 10 sack to bottom of cellar.

Run Johnson tester, packer at 3800'.
 Total depth 3820', anchor 20', recovered
 30' oil cut mud. Oil was heavy and dead.
 Attempted to run Schlumberger Microlog at
 total depth but tool would not go down
 and running of log was waived.

GEOLOGICAL DATA

Maebner	3456 (-1302)
Taranto	3478 (-1304)
Lansing-Kansas City	3494 (-1340)
Base Kansas City	3734 (-1580)
Conglomerate	3784 (-1630)
Simpson	3788 (-1634)
Arbuckle	3799 (-1645)

Rotary Bushing Elevation 2154'.

The undersigned, C. W. Schits, Secretary of PICKRELL DRILLING COMPANY, INC., hereby certifies in behalf of said corporation, that the above log is a true and correct log of the formation encountered in drilling the above well as reflected by the Daily Drilling Reports.

PICKRELL DRILLING COMPANY, INC.

By C. W. Schits
 Secretary

STATE OF KANSAS }
 COUNTY OF SEDWICK } SS

05-24-1950

BE IT REMEMBERED that on this 23rd day of May, 1950, before me, the undersigned, a Notary Public, duly commissioned, in and for the county and state aforesaid, came C. W. Schits, Secretary of Pickrell Drilling Company, Inc., a corporation of the State of Kansas, personally known to me to be such officer, and to be the same person who executed as such officer the foregoing instrument of writing in behalf of said corporation, and he duly acknowledged the execution of the same for himself and for said corporation.

IN WITNESS WHEREOF, I have hereunto set my hand and official seal on the day and year last above written.

Edith Zimmerman
 Notary Public

My commission expires January 28, 1951.
 FILE SEC. 71-23-192
 BOOK PAGE 5 LINE 25