


STATE OF KANSAS
STATE CORPORATION COMMISSION

Give All Information Completely
Make Required Affidavit
Mail or Deliver Report to:
Conservation Division
State Corporation Commission
212 North Market, Insurance Bldg.
Wichita, Kansas

WELL PLUGGING RECORD

Haskell County. Sec. 16 Twp. 27S Rge. 34 W (W)
Location as "NE/CNW%SW%" or footage from lines C NE NE / 4
Lease Owner A. L. ABERCROMBIE, INC.
Lease Name JONES Well No. 1-16
Office Address West Tenth Street, Great Bend, Kansas 67530
Character of Well (completed as Oil, Gas or Dry Hole) Dry Hole
Date well completed June 22 1961
Application for plugging filed December 13 1963
Application for plugging approved December 18 1963
Plugging commenced January 21 1964
Plugging completed January 23 1964
Reason for abandonment of well or producing formation Non-Commercial

NORTH

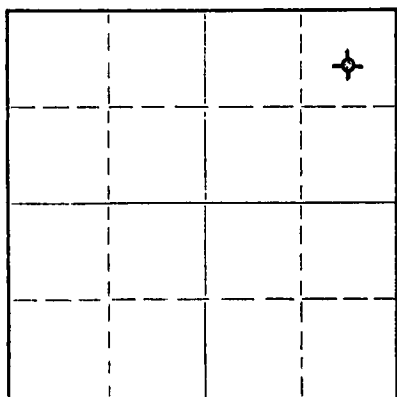

Locate well correctly on above Section Plat

If a producing well is abandoned, date of last production _____ 19____
Was permission obtained from the Conservation Division or its agents before plugging was commenced? Yes

Name of Conservation Agent who supervised plugging of this well Hugh Scott
Producing formation None Depth to top _____ Bottom _____ Total Depth of Well 5154 Feet
Show depth and thickness of all water, oil and gas formations.

OIL, GAS OR WATER RECORDS

CASING RECORD

FORMATION	CONTENT	FROM	TO	SIZE	PUT IN	PULLED OUT
Council Grove	Gas & Water	2799'	2884'	8 5/8"	755'	none
Topeka	Water	3625	3634			
Toronto	Water	3773	3780	4 1/2"	5145	1906
Lansing	Water	3898	3908			
Marmaton	Water	4498	4594			
Morrow	Oil & Water	4916	4985			
Mississippi	Water & Oil	4992	T.D.			

Describe in detail the manner in which the well was plugged, indicating where the mud fluid was placed and the method or methods used in introducing it into the hole. If cement or other plugs were used, state the character of same and depth placed, from _____ feet to _____ feet for each plug set.

P.B.T.D. 2890'

Perforations 2814-19' Squeezed w/ 35 sacks Cement to 1600# - Plug stopped at 1950' - Shot off 4 1/2" casing at 1906' - Pulled 1906' - Spot 35 sacks of cement through 4 1/2" Casing from 648' to 548'. Fill with mud 40'/45'. Spot 15 sacks cement from 45' to surface. Cut off 8 5/8" Casing 3' below ground level and weld on cap.

RECEIVED
STATE CORPORATION COMMISSION

JAN 28 1964

01-28-64

CONSERVATION DIVISION
Wichita, Kansas

(If additional description is necessary, use BACK of this sheet)

Name of Plugging Contractor Sargent's Casing Pulling Service
Address 121 West Ninth St., Liberal, Kansas

STATE OF Kansas COUNTY OF Barton, ss.
Edw. C. Myers, Jr., Petroleum Engineer (employee of owner) or (~~owner~~) of the above-described well, being first duly sworn on oath, says: That I have knowledge of the facts, statements, and matters herein contained and the log of the above-described well as filed and that the same are true and correct. So help me God. A. L. ABERCROMBIE, INC.

(Signature) Edw. C. Myers, Jr.

Edw. C. Myers, Jr., Petroleum Engineer
West Tenth Street, Great Bend, Kansas

SUBSCRIBED AND SWORN TO before me this 27th day of January, 1964

My commission expires March 24, 1967

Notary Public.



PANHANDLE DEVELOPMENT CO., INC.

Box 1226
 Liberal, Kansas

Panhandle Development Co., Inc.
 Jones #1-16, C NE NE, Sec. 16-27S-34W,
 Haskell County, Kansas

Drilling commenced on May 1, 1961,
 Set 8 5/8" casing @ 752.10 K.B.,
 with 500 sacks cement.

blow sand	0- 75	
sand, shells, anhydrite	75- 755	
sand, redbeds, anhydrite	755-1600	
redbeds and anhydrite	1600-1915	
redbeds and shale	1915-2090	
shale and anhydrite	2090-2295	
lime and shale	2295-3625	
lime	3625-3725	
lime and shale	3725-3878	
lime with shale stringers	3878-5150	T.D.

RECEIVED
 STATE CORPORATION COMMISSION

DEC 18 1961
 12-18-63
 CONSERVATION DIVISION
 Wichita, Kansas

Ran 151 joints 4 1/2" casing set at 5145' R.B.T.D.
 with 275 sacks cement. Set Stage Tool at 2968', float at
 5109'. Job complete at 9:00 o'clock A.M. 5-18-61.

We hereby certify that this is a complete drillers log
 of the above described well as taken from our daily drilling reports.

PANHANDLE DEVELOPMENT CO., INC.

By: Jack K. Wharton
 Jack K. Wharton
 Geological Engineer