


WELL LOG BUREAU - KANSAS GEOLOGICAL SOCIETY 15-015-40191-0000
412 Union National Bk. Bldg., Wichita, Kansas

Company - ADAIR & PHIL-HAN OIL
Farm - Robinson No. 10.

SEC. 18 T. 25 R. 5 E
CNW SW

Total Depth. 2591'
Comm. 1-3-45 Comp. 1-26-45
Shot or Treated.
Contractor.
Issued. 2-17-45.

County. Butler
KANSAS

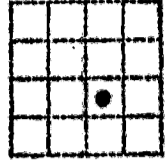

CASING:

12 1/2" 175'
10" 965'
8 1/4" 1680'
6" 2396' P
5" 2574' Com.

Elevation. _____


Production. 200 B.

Figures Indicate Bottom of Formations.

cellar	8	shale	1350
shale	65	lime	1435
fresh wtr 60-65		3-10 BWPB 1380-90	
lime	80	shale	1500
shale	120	lime	1575
lime	130	shale	1595
lime brkn	165	lime	1605
shale	225	shale	1615
lime	255	shale sdy	1650
shale	265	sand(HFW 1650-60)	1670
red rock	275	shale	1680
lime	280	shale, bailing wtr	1700
shale	305	shale	1720
lime	315	lime	1725
shale	420	shale	1755
lime	445	lime	1765
shale	455	shale	1825
lime	460	lime Lansing	1845
shale	510	1BWH 1835-45	
lime	520	lime	1955
shale	530	shale	1960
lime	535	lime	1963
shale	545	shale	2110
lime	550	lime K.C.	2120
shale	565	lime	2260
lime	585	1BWH 2205-15	
shale	630	shale	2265
lime	640	lime	2280
shale	670	shale	2350
shale & shells	710	lime	2365
lime	715	hole caving 2365-75	
shale	765	shale	2375
4BWPB 765-80		lime	2395
shale sdy	780	Corr. 2375 equals	2386
shale	790	lime, bailing wtr	2405
lime	795	shale	2430
shale	820	lime	2455
lime	830	shale	2460
shale	875	lime	2485
lime	960	shale	2500
shale	965	red rock	2505
lime	975	shale	2530
shale	1015	lime	2535
lime	1020	sand, shale, chert,	
shale	1070	little red sh	2558
lime	1095	Corr. Meas. 2525=2520	
shale	1105	shale brown, some	
lime	1115	red	2561
shale	1120	tripolitic chert,	
lime	1125	some green sh	2566
shale	1190	more trip. chert	2570
lime	1215	chert wh & trip.	2574
shale	1225	bailing wtr	
lime	1260	lime(sh oil 2573-74)	2587
shale	1270	sand oil	2591
lime	1290	Total Depth.	
shale	1305		
lime	1320		
shale	1330	Top Miss. 2564	
lime	1345		

PLUGGING
FILE NO. 19 258E
BOOK PAGE 26 LINE 21

2574'
17 1/2'
19 258E
Plugging

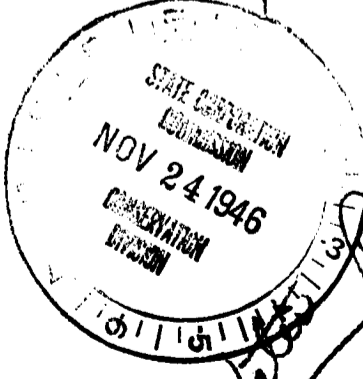

Walter Polunin

2 1/2 Lbs Cement Dumped at 2591
mudded to 200ft Bridged with
15 Lbs Cement mudded to Bottom
of Cellar & 5 Lbs Cement