


Give All Information Completely
Make Required Affidavit
Mail or Deliver Report to:
Conservation Division
State Corporation Commission
212 No. Market
Wichita, Kansas

15-05130-272-00-00
WELL PLUGGING RECORD

NORTH

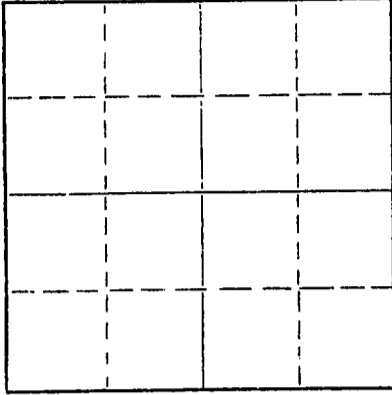

Locate well correctly on above
Section Plat

Ellis County, Sec. 11 Twp. 13S Rge. 19W (E) (W)
Location as "NE/CNW/SW" or footage from lines SE SW
Lease Owner Okmar Oil Company
Lease Name Gassner Well No. 1
Office Address 1130 Wichita Plaza Bldg., Wichita, Ks. 67202
Character of Well (completed as Oil, Gas or Dry Hole) Dry Hole
Date well completed 2-23-66 19
Application for plugging filed 2-23-66 19
Application for plugging approved 2-23-66 19
Plugging commenced 2-23-66 19
Plugging completed 2-23-66 19
Reason for abandonment of well or producing formation Dry Hole

If a producing well is abandoned, date of last production 19
Was permission obtained from the Conservation Division or its agents before plugging was commenced? yes

Name of Conservation Agent who supervised plugging of this well Archie Elving for Gilbert Leiker
Producing formation _____ Depth to top _____ Bottom _____ Total Depth of Well 3747 Feet
Show depth and thickness of all water, oil and gas formations.

OIL, GAS OR WATER RECORDS

CASING RECORD

FORMATION	CONTENT	FROM	TO	SIZE	PUT IN	PULLED OUT
				8 5/8"	201'	none

Describe in detail the manner in which the well was plugged, indicating where the mud fluid was placed and the method or methods used in introducing it into the hole. If cement or other plugs were used, state the character of same and depth placed, from _____ feet to _____ feet for each plug set.

Set Plug @ 540' with 20 sacks cement
Set Plug @ 200' with 20 sacks cement
Bridged Plug @ 40' with 1/2 sack hulls and 10 sacks cement

RECEIVED
STATE CORPORATION COMMISSION

MAR 1 1966

(If additional description is necessary, use BACK of this sheet)

Name of Plugging Contractor Leben Drilling, Inc.
Address Box 486, Great Bend, Kansas 67530

STATE OF KANSAS, COUNTY OF BARTON, ss.

Leslie Kite (employee of owner) or (owner or operator) of the above-described well, being first duly sworn on oath, says: That I have knowledge of the facts, statements, and matters herein contained and the log of the above-described well as filed and that the same are true and correct. So help me God.

(Signature) Leslie Kite

P. O. Box 486, Great Bend, Kansas
(Address)

SUBSCRIBED AND SWORN to before me this 28th day of February, 1966

My commission expires April 1, 1967

Ulanda Nichols
Ulanda Nichols Notary Public.

15051-30272-0000
DRILLER'S LOG

COMPANY: Okmar Oil Company
CONTRACTOR: LEBEN DRILLING, INC.
FARM: GASSNER #1
LOCATION: SE SW Sec. 11-13S-19W
ELLIS COUNTY, KANSAS
COMMENCED: 2-14-66
COMPLETED: 2-23-66

0	40	Rock
40	201	Clay, Blue Shale
201	500	Shale
500	905	Shale, Shells
905	1090	Sand
1090	1425	Shale
1425	1468	Anhydrite
1468	1870	Shale, Shells
1870	2170	Shale, Lime
2170	2785	Lime, Shale
2785	3161	Shale, Lime
3161	3747	Lime
	<u>3747</u>	<u>RTD - D. & A.</u>

RECEIVED
STATE COMMISSION
MAR 1 1966
CONSERVATION DIVISION
Wichita, Kansas

8 5/8" used surface casing set @ 201' cemented with 150 sacks Sunset

I, Leslie Kite, do hereby certify that the above and foregoing is a true and correct copy of the log of the Gassner #1 well, located SE SW of Section 11, Township 13 South, Range 19 West, Ellis County, Kansas, as reflected by the records of Leben Drilling, Inc.

Leslie Kite

Leslie Kite

STATE OF KANSAS)
) SS
COUNTY OF BARTON)

Subscribed and sworn to and before me, a Notary Public, in and for Barton County, Kansas, this 28th day of February, 1966.

Ulanda Nichols

Ulanda Nichols

My Commission Expires:
April 1, 1967