

CARD MUST BE TYPED

State of Kansas
NOTICE OF INTENTION TO DRILL

CARD MUST BE SIGNED

(see rules on reverse side)

Starting Date: 1 30 85
month day year

API Number IS- 051-24,127-00-00

OPERATOR: License # 5562
Name Liberty Operations & Completions, Inc.

SW SE NW Sec 17 Twp 13 S, Rge 19 East West
(location)

Address 308 West Mill
City/State/Zip Plainville, KS 67663
Contact Person David L. Comeau
Phone (913) 434-4686

2970 Ft North from Southeast Corner of Section
3630 Ft West from Southeast Corner of Section
(Note: Locate well on Section Plat on reverse side)

CONTRACTOR: License # 5665
Name Pioneer Drilling Company, Inc.
City/State Plainville, KS 67663

Nearest lease or unit boundary line 330 feet.
County Ellis
Lease Name Bemis Well# 1

Well Drilled For: Well Class: Type Equipment:
 Oil Swd Infield Mud Rotary
 Gas Inj Pool Ext. Air Rotary
 OWWO Expl Wildcat Cable

Domestic well within 330 feet: yes no
Municipal well within one mile: yes no

If OWWO: old well info as follows:
Operator _____
Well Name _____
Comp Date _____ Old Total Depth _____
Projected Total Depth 3780 feet
Projected Formation at TD Arbuckle
Expected Producing Formations Arbuckle

Depth to Bottom of fresh water 100 480 ^{mHC} feet
Lowest usable water formation Dakota
Depth to Bottom of usable water 550 750 feet
Surface pipe by Alternate: 1 2
Surface pipe to be set 250 500 ^{mHC} feet
Conductor pipe if any required N/A feet
Ground surface elevation _____ feet MSL.
This Authorization Expires 6-14-85
Approved By 12-14-84 *[Signature]*

I certify that we will comply with K.S.A. 55-101, et seq., plus eventually plugging hole to K.C.C. specifications.

Date 12-11-84 Signature of Operator or Agent *[Signature]*

Title Well Pres.
mHC/NOHE 12/14/84
Form C-1 4/84

STATE CORPORATION COMMISSION OF KANSAS

Must be filed with the K.C.C. five (5) days prior to commencing well
This card void if drilling not started within six (6) months of date received by K.C.C.


DEC 14 1984

12-14-84

Conservation Division

A Regular Section of Land

1 Mile = 5,280 Ft.

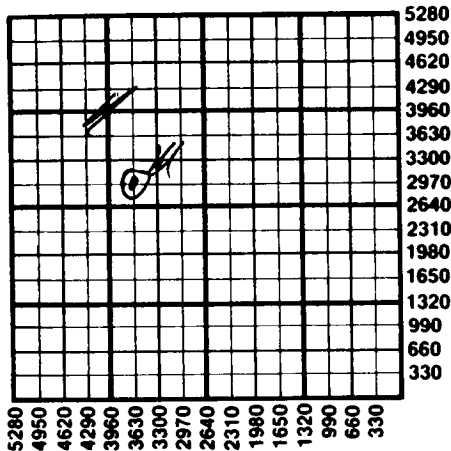

Important procedures to follow :

1. Notify District office before setting surface casing.
2. Set surface casing by circulating cement to the top.
3. File completion forms ACO-1 with K.C.C. within 90 days of well completion, following instructions on ACO-1, side 1, and including copies of wireline logs.
4. Notify District office 48 hours prior to old well workover or re-entry.
5. Prior to plugging, prepare a plugging plan, then obtain agreement from the appropriate district office for an approved plugging plan.
6. Submit plugging report (CP-4) to K.C.C. after plugging is completed.
7. Obtain an approved injection docket number before disposing of salt water.
8. Notify K.C.C. within 10 days when injection commences or terminates.
9. If an alternate 2 completion, cement in the production pipe from below any usable water to surface within 120 days of spud date.

**State Corporation Commission of Kansas
 Conservation Division
 200 Colorado Derby Building
 Wichita, Kansas 67202
 (316) 263-3238**