

CARD MUST BE TYPED

State of Kansas

CARD MUST BE SIGNED

NOTICE OF INTENTION TO DRILL \*Amendment to change location.

(see rules on reverse side)

Expected Spud Date... November 14, 1988 month day year

API Number 15-067-20841

OPERATOR: License # 5447 Name OXY USA Inc. Address P. O. Box 26100 City/State/Zip Oklahoma City, OK 73126-0100 Contact Person Raymond Hui Phone (405) 749-2741

\*C-NW4 SE/4 Sec. 19 Twp. 28. S, Rg. 36... X West \*1980 Ft. from South Line of Section \*1980 Ft. from East Line of Section

(Note: Locate well on Section Plat on reverse side)

CONTRACTOR: License # Name Unknown at this time City/State

Nearest lease or unit boundary line 1980 feet County Grant Lease Name Spikes B Well # 2

Well Drilled For: Well Class: Type Equipment: Oil Storage Infield Mud Rotary X Gas Inj Pool Ext Air Rotary OWWO Expl Wildcat Cable

Ground surface elevation \*3055 feet MSL Domestic well within 330 feet: yes X no Municipal well within one mile: yes X no

If OWWO: old well info as follows: Operator Well Name Comp Date Old Total Depth

Depth to bottom of fresh water 450' Depth to bottom of usable water 660' Surface pipe by Alternate: 1 X 2

I certify that well will comply with K.S.A. 55-101, et seq., plus eventually plugging hole to KCC specifications. Date 11-7-88 Signature of Operator or Agent Raymond Hui Senior Accounting Controls Analyst

For KCC Use: Conductor Pipe Required feet; Minimum Surface Pipe Required 680' feet per Alt. This Authorization Expires 3-27-89 Approved By LKM 11-9-88 ORIG. RCV'D: 9-27-88

EFFECTIVE DATE: 10-2-88


\*WAS: C-SE-NW, 3300' FSL 3300' FEL, 3052' GROUND SURFACE ELEV.

Must be filed with the K.C.C. five (5) days prior to commencing well  
This card void if drilling not started within six (6) months of date received by K.C.C.

**Important procedures to follow:**

1. Notify District office before setting surface casing.
2. Set surface casing by circulating cement to the top.
3. File completion forms ACO-1 with K.C.C. within 120 days of well spud date, following instructions on ACO-1, side 1, and including copies of wireline logs.
4. Notify District office 48 hours prior to old well workover or re-entry.
5. Prior to filing Intent, prepare a proposed plugging plan in case well is D & A, then obtain approval of plan when calling district office prior to setting surface pipe.
6. Submit plugging report (CP-4) to K.C.C. after plugging is completed.
7. Obtain an approved injection docket number before disposing of salt water.
8. Notify K.C.C. within 10 days when injection commences or terminates.
9. If an alternate 2 completion, cement in the production pipe from below any usable water to surface within 120 days of spud date.

**A Regular Section of Land**  
1 Mile = 5,280 Ft.

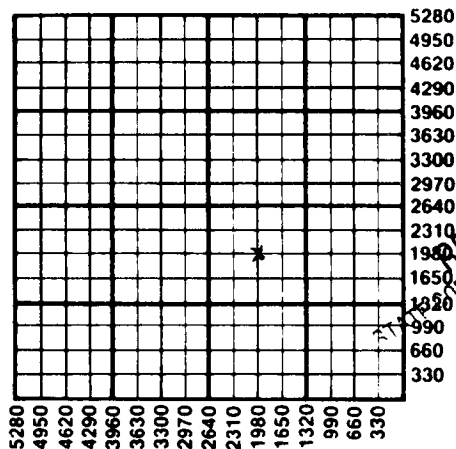

RECEIVED  
STATE CORPORATION COMMISSION  
NOV 3 1988  
CONSERVATION DIVISION  
Wichita, Kansas

State Corporation Commission of Kansas  
Conservation Division  
200 Colorado Derby Building  
Wichita, Kansas 67202-1212  
(316) 263-3238