

CARD MUST BE TYPED

# State of Kansas NOTICE OF INTENTION TO DRILL

CARD MUST BE SIGNED

(see rules on reverse side)

Starting Date: December 11, 1984  
month day year

API Number 15- 051-24,092-00-00

OPERATOR: License # 5273

SW. NW. NE ... Sec 20. Twp 13. S. Rge 19.  East  West  
(location)

Name .. Kiowa Exploration Company

Address .. 110 So. Main, Suite #510

City/State/Zip .. Wichita, Kansas 67202

Contact Person .. J. Corry Tinsmon

Phone .. (316) 267-0228

4290 ..... Ft North from Southeast Corner of Section

2310 ..... Ft West from Southeast Corner of Section

(Note: Locate well on Section Plat on reverse side)

CONTRACTOR: License # 5107

Nearest lease or unit boundary line ..... 330 ..... feet.

County .. Ellis

Lease Name .. Bemis Well# .. 1

Name .. H-30 Drilling, Inc.

City/State .. Wichita, Kansas 67202

Domestic well within 330 feet :  yes  no

Municipal well within one mile :  yes  no

Well Drilled For: Well Class: Type Equipment:

- Oil  Swd  Infield  Mud Rotary
- Gas  Inj  Pool Ext.  Air Rotary
- OWWO  Expl  Wildcat  Cable

If OWWO: old well info as follows:

Operator .....

Well Name .....

Comp Date ..... Old Total Depth .....

Projected Total Depth ..... 3800 ..... feet

Projected Formation at TD .. Arbuckle

Expected Producing Formations .. KC & Arbuckle

Depth to Bottom of fresh water ..... 100 ..... feet

Lowest usable water formation ..... 200 Dakota ..... feet

Depth to Bottom of usable water ..... 400 750 ..... feet

Surface pipe by Alternate : 1  2

Surface pipe to be set ..... 200 ..... feet

Conductor pipe if any required ..... feet

Ground surface elevation ..... 2073 ..... feet MSI.

This Authorization Expires ..... 5-13-85

Approved By ..... 11-13-84 [Signature]

I certify that we will comply with K.S.A. 55-101, et seq., plus eventually plugging hole to K.C.C. specifications.

Date .. 11-13-84 Signature of Operator or Agent

Title .. Managing Partner

MHC/KCOHE 11/3/84

RECEIVED  
COMMISSION

NOV 13 1984


CONSERVATION DIVISION  
Wichita, Kansas

Must be filed with the K.C.C. five (5) days prior to commencing well  
This card void if drilling not started within six (6) months of date received by K.C.C.

A Regular Production of Land  
5,280 Ft.

STATION

11-13-84

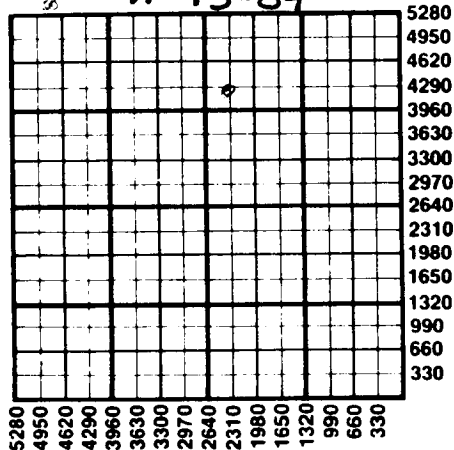

**Important procedures to follow :**

1. Notify District office before setting surface casing.
2. Set surface casing by circulating cement to the top.
3. File completion forms ACO-1 with K.C.C. within 90 days of well completion, following instructions on ACO-1, side 1, and including copies of wireline logs.
4. Notify District office 48 hours prior to old well workover or re-entry.
5. Prior to plugging, prepare a plugging plan, then obtain agreement from the appropriate district office for an approved plugging plan.
6. Submit plugging report (CP-4) to K.C.C. after plugging is completed.
7. Obtain an approved injection docket number before disposing of salt water.
8. Notify K.C.C. within 10 days when injection commences or terminates.
9. If an alternate 2 completion, cement in the production pipe from below any usable water to surface within 120 days of spud date.

State Corporation Commission of Kansas  
Conservation Division  
200 Colorado Derby Building  
Wichita, Kansas 67202  
(316) 263-3238