

CARD MUST BE TYPED

State of Kansas

CARD MUST BE SIGNED

NOTICE OF INTENTION TO DRILL

(see rules on reverse side)

Expected Spud Date. July 1 1988
month day year

OPERATOR: License # 5285
 Name The Dane G. Hansen Trust
 Address P. O. Box 187
 City/State/Zip Logan, Kansas 67646
 Contact Person Dane G. Bales
 Phone 913-689-4816

CONTRACTOR: License # 5783
 Name Galloway Drilling Co., Inc.
 City/State Wichita, Kansas 67202

Well Drilled For: Well Class: Type Equipment:
 — Oil — Storage — Infield ☒ Mud Rotary
 — Gas — Inj — Pool Ext. — Air Rotary
☒ OWWO — Expl — Wildcat — Cable

If OWWO: old well info as follows:

Operator Petroleum, Inc.
 Well Name Schuster 'C' #1
 Comp Date 10/12/87. Old Total Depth 3950

I certify that well will comply with K.S.A. 55-101, et seq., plus eventually plugging hole to KCC specifications.

Date 6/27/88 Signature of Operator or Agent Title Manager

For KCC Use:

Conductor Pipe Required feet; Minimum Surface Pipe Required 223 feet per Alt. X 2

This Authorization Expires 12-28-88 Approved By 6-28-88

EFFECTIVE DATE: 7-3-88

API Number 15—051-24,523—A0000
 SE NE SE Sec. 1 Twp. 13 S. Rg. 20 — East
 1650 Ft. from South Line of Section
 330 Ft. from East Line of Section

(Note: Locate well on Section Plat on reverse side)


Nearest lease or unit boundary line 330 feet
 County Ellis
 Lease Name Schuster Well # 2
 Ground surface elevation 2183 feet MSL
 Domestic well within 330 feet: —yes ☒ no
 Municipal well within one mile: —yes ☒ no
 Depth to bottom of fresh water 150'
 Depth to bottom of usable water 750'
 Surface pipe by Alternate: 1 — 2 X
 Surface pipe ~~planned~~ set 223
 Conductor pipe required
 Projected Total Depth 3950 feet
 Formation Arbuckle

Must be filed with the K.C.C. five (5) days prior to commencing well
This card void if drilling not started within six (6) months of date received by K.C.C.

Important procedures to follow:

1. Notify District office before setting surface casing.
2. Set surface casing by circulating cement to the top.
3. File completion forms ACO-1 with K.C.C. within 120 days of well spud date, following instructions on ACO-1, side 1, and including copies of wireline logs.
4. Notify District office 48 hours prior to old well workover or re-entry.
5. Prior to filing Intent, prepare a proposed plugging plan in case well is D & A, then obtain approval of plan when calling district office prior to setting surface pipe.
6. Submit plugging report (CP-4) to K.C.C. after plugging is completed.
7. Obtain an approved injection docket number before disposing of salt water.
8. Notify K.C.C. within 10 days when injection commences or terminates.
9. If an alternate 2 completion, cement in the production pipe from below any usable water to surface within 120 days of spud date.

**A Regular Section of Land
1 Mile = 5,280 Ft.**

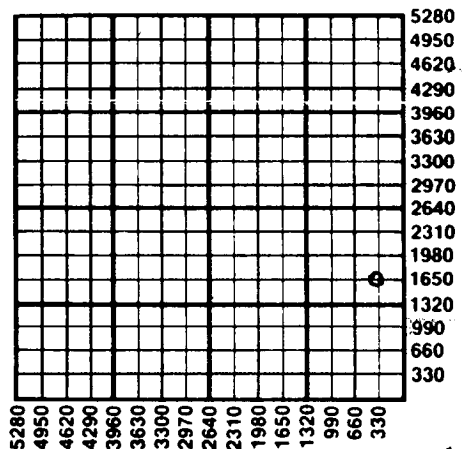

JUN 20 1988
06-28-88

State Corporation Commission of Kansas
Conservation Division
200 Colorado Derby Building
Wichita, Kansas 67202-1212
(316) 263-3238