


WELL PLUGGING RECORD

Give All Information Completely
Make Required Affidavit
Mail or Deliver Report to:
Conservation Division
State Corporation Commission
800 Bittling Building
Wichita, Kansas

Ellis County. Sec. 12 Twp. 13 Rge. 20 (E) W (W)
Location as "NE/CNW $\frac{1}{4}$ SW $\frac{1}{4}$ " or footage from lines _____
Lease Owner John Lindas Oil, Inc.
Lease Name Spilker Well No. 1
Office Address 1316 Union Nat'l. Bank Bldg.; Wichita 2, Kansas
Character of Well (completed as Oil, Gas or Dry Hole) Dry Hole
Date well completed 11-15-51 19____
Application for plugging filed 11-15-1951
Application for plugging approved 11-15-1951
Plugging commenced 11-15-1951
Plugging completed 11-15-1951
Reason for abandonment of well or producing formation Dry Hole
If a producing well is abandoned, date of last production _____ 19____
Was permission obtained from the Conservation Division or its agents before plugging was commenced? yes

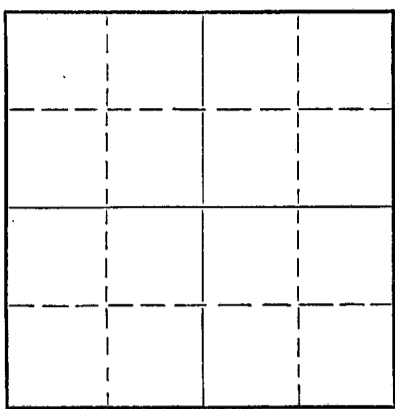

Locate well correctly on above Section Plat

Name of Conservation Agent who supervised plugging of this well Eldon Petty
Producing formation _____ Depth to top _____ Bottom _____ Total Depth of Well 3810 Feet
Show depth and thickness of all water, oil and gas formations.

OIL, GAS OR WATER RECORDS

CASING RECORD

Formation	Content	From	To	Size	Put In	Pulled Out
				8 5/8"	225'	0

Describe in detail the manner in which the well was plugged, indicating where the mud fluid was placed and the method or methods used in introducing it into the hole. If cement or other plugs were used, state the character of same and depth placed, from _____ feet to _____ feet for each plug set.

Filled with mud to 215', set plug, 1/2 sack hulls and 15 sacks cement, plug at 110', 1/2 sack hulls and 10 sacks cement

11-21-1951

RECEIVED
STATE CORPORATION COMMISSION
NOV 21 1951
CONSERVATION DIVISION
WICHITA, KANSAS

(If additional description is necessary, use BACK of this sheet)
Name of Plugging Contractor John Lindas Oil, Inc.
Address 1316 Union Nat'l. Bank Bldg.; Wichita 2, Kansas.

STATE OF KANSAS COUNTY OF STODOLICK SS.
I, Edward W. Wiens (employee of owner) or owner or operator of the above-described well,

being first duly sworn on oath, says: That I have knowledge of the facts, statements, and matters herein contained and the log of the above-described well as filed and that the same are true and correct. So help me God.

(Signature) Edward W. Wiens
1316 Union Nat'l. Bank Bldg.; Wichita 2, Kansas.
(Address)

SUBSCRIBED AND SWORN to before me this 19th day of November, 19 51

Catherine Dancy
Notary Public.

My commission expires March 25, 1952.

23-8390-3 6-51-20M
PLUGGING
FILE SEC 12 T 13 R 20 W
BOOK PAGE 124 LINE 31

15-051-00640-00-00

To: Kenneth Rupp
Champlin Refining Company
Lion Oil Company
John Lindas Oil, Inc.

Lease: Spilker #1

County: Ellis, Kansas
Location: SE NE SW
Section: 12-13S-20W
Elevation: 2084 K.B. 2081 D.F.

Rotary Total Depth: 3810'
Commenced: 11-3-51; Completed 11-15-51
Casing 8 5/8" @ 225' with 150 sacks of cement

Contractor: John Lindas Oil, Inc. Rig #3
1316 Union National Bank Building
Wichita 2, Kansas

FIGURES INDICATE BOTTOM OF FORMATIONS

0	to	850	Shale
850		1250	Sand and Shale
1250		1460	Red Bed
1460		1510	Anhydrite Lime
1510		1530	Shale
1530		2420	Shale and Shells
2420		2550	Lime
2550		2680	Shale and Lime Streaks
2680		2825	Lime and Shale
2825		3245	Shale and Shells
3245		3365	Lime
3365		3450	Shale and Shells
3450		3642	Lime
3642		3715	Shale and Lime
3715		3745	Lime
3745		3770	Conglomerate and Arbuckle Lime
3770		3810	T.D. Arbuckle Lime

STATE OF KANSAS)
) SS
COUNTY OF SEDGWICK)

I, the undersigned, being duly sworn on oath, state that the above statement and log is a true and correct record and log of the well drilled by John Lindas Oil, Inc. at the location above described.

Edward W. Wiens

Subscribed and sworn to before me, this 20th day of November, 1951.

Catherine Darcy

Notary Public

My commission expires March 29, 1952

My commission expires _____

43
NOV 20 1951
BOOK PAGE 184 LINE 31

11-21-1951