


STATE OF KANSAS  
STATE CORPORATION COMMISSION

Form CP-4

Give All Information Completely  
Make Required Affidavit  
Mail or Deliver Report to:  
Conservation Division  
State Corporation Commission  
212 No. Market  
Wichita, Kansas 67202

15:05:20195:00:00  
WELL PLUGGING RECORD

NORTH

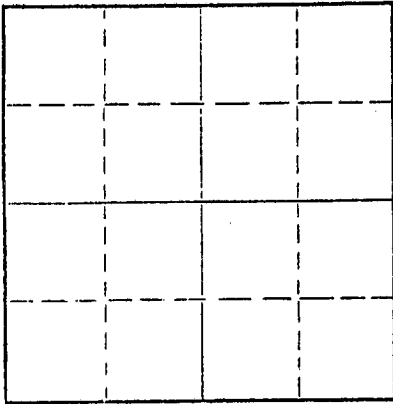

Locate well correctly on above  
Section Plat

Ellis County, Sec. 22 Twp. 13S Rge. (E) 18 (W)  
Location as "NE/CNWxSWx" or footage from lines NW SE SE  
Lease Owner L. H. Pearson  
Lease Name R. Stackhouse Well No. 1  
Office Address \_\_\_\_\_  
Character of Well (completed as Oil, Gas or Dry Hole) Dry Hole  
Date well completed November 28 1970  
Application for plugging filed November 28 1970  
Application for plugging approved November 28 1970  
Plugging commenced November 28 1970  
Plugging completed November 28 1970  
Reason for abandonment of well or producing formation Dry Hole

If a producing well is abandoned, date of last production \_\_\_\_\_ 19\_\_\_\_  
Was permission obtained from the Conservation Division or its agents before plugging was commenced? Yes

Name of Conservation Agent who supervised plugging of this well Don Truan, Russell, Kansas  
Producing formation \_\_\_\_\_ Depth to top \_\_\_\_\_ Bottom \_\_\_\_\_ Total Depth of Well 3680 Feet  
Show depth and thickness of all water, oil and gas formations.

OIL, GAS OR WATER RECORDS

CASING RECORD

FORMATION	CONTENT	FROM	TO	SIZE	PUT IN	PULLED OUT
		0	500	8-5/8"	561.88	None

Describe in detail the manner in which the well was plugged, indicating where the mud fluid was placed and the method or methods used in introducing it into the hole. If cement or other plugs were used, state the character of same and depth placed, from \_\_\_\_\_ feet to \_\_\_\_\_ feet for each plug set.

Set First plug at 700' with 40 sacks cement.  
Set second plug at 400' with 25 sacks cement.  
Set top plug at 40' with 10 sacks cement.  
Job by Allied Cementing Co.  
Job complete @ 8:30 p.m., 11/28/70.

RECEIVED  
STATE CORPORATION COMMISSION  
DEC 2 - 1970  
CONSERVATION DIVISION  
Wichita, Kansas

(If additional description is necessary, use BACK of this sheet)

Name of Plugging Contractor Gabbert-Jones, Inc.  
Address 830 Sutton Place, Wichita, Kansas 67202

STATE OF Kansas, COUNTY OF Sedgwick, ss.

James S. Sutton, II (employee of owner) or (owner or operator) of the above-described well, being first duly sworn on oath, says: That I have knowledge of the facts, statements, and matters herein contained and the log of the above-described well as filed and that the same are true and correct. So help me God.

(Signature) James S. Sutton  
830 Sutton Place, Wichita, Kansas 67202  
(Address)

Subscribed and sworn to before me this 1 day of December, 1970



My commission expires Feb. 1, 1972

Barbara J. Layton  
Barbara J. Layton Notary Public.

GABBERT-JONES, INC.  
WICHITA, KANSAS  
DRILLERS' WELL LOG

R. STACKHOUSE #1  
 NW SE SE Section 22-13S-18W  
 Ellis County, Kansas

Commenced: November 19, 1970  
 Completed: November 28, 1970

OPERATOR - L. H. Pearson

15-051-20695-00-00

RECEIVED  
 STATE CORPORATION COMMISSION  
 DEC 2 - 1970  
 CONSERVATION DIVISION  
 Wichita, Kansas

DEPTH		FORMATION	REMARKS
From	To		
0	500	Top soil, clay, shale	Ran 16 joints of 8-5/8" casing, set @ 569.88 w/220 sacks cement.
500	572	Blue shale	
572	780	Shale and shells	
780	990	Sand	
990	1150	Shale, sand and shells	
1150	1328	Shale and redbed	
1328	1368	Anhydrite	
1368	1510	Shale	
1510	2242	Shale and lime	
2242	2625	Lime and shale	
2625	3110	Shale and lime	
3110	3148	Lime and shale	
3148	3632	Lime	
3632	3650	Conglomerate	
3650	3680	Lime	
3680	TD		Dry and abandoned.

I, James S. Sutton, II, certify this is a correct copy of the Drillers' Log for the well drilled in the NW SE SE Section 22-13S-18W, Ellis County, Kansas, to the best of my knowledge and belief.

*James S. Sutton, II*  
 \_\_\_\_\_  
 JAMES S. SUTTON, II

STATE OF KANSAS            )  
                                   ) SS  
 COUNTY OF SEDGWICK        )

Before me, the undersigned, a Notary Public within and for said County and State, on this 30th day of November, 1970, personally appeared James S. Sutton, II, to me personally known to be the identical person who executed the within and foregoing instrument and acknowledged to me that he executed the same as his free and voluntary act and deed for the uses and purposes therein set forth.

IN WITNESS WHEREOF, I have hereunto set my hand and official seal the day and year last above written.

*Barbara J. Layton*  
 \_\_\_\_\_  
 Barbara J. Layton, Notary Public

My Commission Expires Feb. 1, 1972.

