


STATE OF KANSAS
STATE CORPORATION COMMISSION

1505/22/99-00-00
WELL PLUGGING RECORD

Give All Information Completely
Make Required Affidavit
Mail or Deliver Report to
Conservation Division
State Corporation Comm.
245 North Water
Wichita, KS 67202

Ellis County, Sec. 22 Twp. 13S Rge. 18 E/W
Location as "NE/CNW $\frac{1}{4}$ /SW $\frac{1}{4}$ " or footage from lines
NW NW SE

Lease Owner Energy Reserves Group, Inc.
Lease Name Stackhouse Well No. 1
Office Address 925 Patton Rd., Great Bend, KS 67530
Character of Well (Completed as Oil, Gas or Dry Hole)
Dry Hole

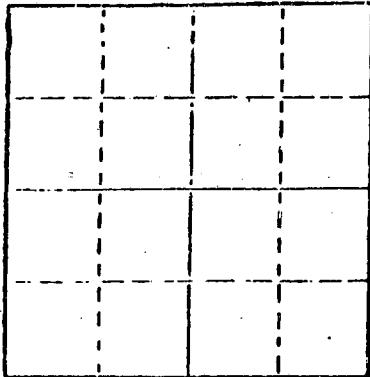

Locate well correctly on above
Section Plat

Date Well completed 1-5 1981
Application for plugging filed 1-4 1981
Application for plugging approved 1-4 1981
Plugging commenced 1-4 1981
Plugging completed 1-5 1981
Reason for abandonment of well or producing formation

Dry Hole
If a producing well is abandoned, date of last production 19

Was permission obtained from the Conservation Division or
its agents before plugging was commenced? Yes

Name of Conservation Agent who supervised plugging of this well Marion Schmidt
Producing formation Depth to top Bottom Total Depth of Well
Show depth and thickness of all water, oil and gas formations.

OIL, GAS OR WATER RECORDS

CASING RECORD

FORMATION	CONTENT	FROM	TO	SIZE	PUT IN	PULLED OUT
				8-5/8	159	-0-

Describe in detail the manner in which the well was plugged, indicating where the mud fluid
was placed and the method or methods used in introducing it into the hold. If cement or other
plugs were used, state the character of same and depth placed, from feet to
feet for each plug set.

Mud laden fluid 3715' - 159'
70 sks cement @ 660'
25 sks cement @ 240'
10 sks cement @ 40'
5 sks cement in rat hole

RECEIVED
STATE CORPORATION COMMISSION

JAN 7 1981

(If additional description is necessary, use BACK of this sheet)

Name of Plugging Contractor Emphasis Oil Operations

CONSERVATION DIVISION
Wichita, Kansas

STATE OF Kansas COUNTY OF Russell, ss.
Joe K. Branum (employee of owner) or (owner or operator)
of the above-described well, being first duly sworn on oath, says: That I have knowledge of
the facts, statements, and matters herein contained and the log of the above-described well
as filed and that the same are true and correct. So help me God.


(Signature)

Joe K. Branum
Box 506, Russell, KS 67665
(Address)

SUBSCRIBED AND SWORN TO before me this 6th day of January, 19 81

Glenda R. Tiffin
Notary Public.

My commission expires February 6, 1984

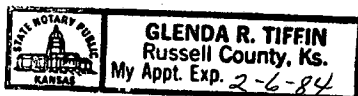

EMPHASIS OIL OPERATIONS

P. O. Box 506

Russell, Kansas 67665

15051-22199-00-00
DRILLERS LOG

OPERATOR: Energy Reserves Group, Inc.
925 Patton Rd.
Great Bend, Kansas 67530

CONTRACTOR: Emphasis Oil Operations
P. O. Box 506
Russell, Kansas 67665

LEASE: Stackhouse WELL: #1

LOCATION: NW NW SE
Section 22-13S-18W
Ellis County, Kansas

Total Depth: 3715'

Elevation:

Commenced: 12-26-80

Completed: 1-5-81

Casing: 8-5/8" @ 159'

Status: Dry Hole

DEPTHS & FORMATIONS

(All measurements from K.B.)

Soil & clay	40	Shale & lime	3110
Shale & sand	980	Lime & shale	3620
Shale & Red bed	1347	Lime	3680
Anhydrite	1390	Lime & shale	3700
Shale	2840	Lime (R.T.D.)	3715

STATE OF KANSAS)
) ss:
COUNTY OF RUSSELL)

I, Joe K. Branum, of Emphasis Oil Operations, state that the above and foregoing is a true and correct log of the above captioned well.

Joe K. Branum

Joe K. Branum
JAN 7 1981

Subscribed and sworn to before me this 6th day of January, 1981.
My Commission Expires: February 6, 1984.

RECEIVED
CONSERVATION DIVISION
Wichita, Kansas

NOTARY PUBLIC
KANSAS
GLEND A. R. TIFFIN
Russell County, Ks.
My Appt. Exp. 2-6-84

Glenda R. Tiffin

Notary Public