


STATE OF KANSAS
STATE CORPORATION COMMISSION

15 051 23421 00 00
WELL PLUGGING RECORD

Give All Information Completely
Make Required Affidavit
Mail or Deliver Report to
Conservation Division
State Corporation Comm.
245 North Water
Wichita, KS 67202

Ellis County, Sec. 22 Twp. 13S Rge. 18 E/W
Location as "NE/CNW 1/4 SW 1/4" or footage from lines

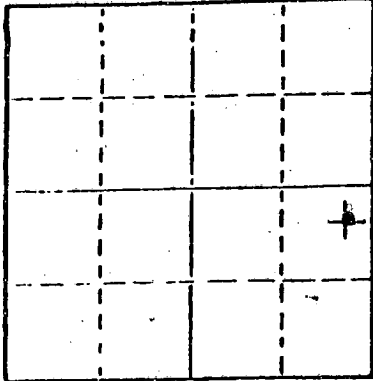

Locate well correctly on above
Section Plat

NE NE SE
Lease Owner Energy Reserves Group, Inc.
Lease Name T. Braun Well No. 1
Office Address 925 Patton Rd, Great Bend, KS 67530
Character of Well (Completed as Oil, Gas or Dry Hole)
Oil Well

Date Well completed October 24 19 83
Application for plugging filed October 2 19 84
Application for plugging approved October 10 19 84
Plugging commenced October 30 19 84
Plugging completed November 1 19 84
Reason for abandonment of well or producing formation

Uneconomical to operate
If a producing well is abandoned, date of last production
August 16 19 84

Was permission obtained from the Conservation Division or
its agents before plugging was commenced? Yes

Name of Conservation Agent who supervised plugging of this well Gilbert Scheck
Producing formation L-KC & Toronto, Depth to top 3353 Bottom 3516 Total Depth of Well 3683'
Show depth and thickness of all water, oil and gas formations.

OIL, GAS OR WATER RECORDS

CASING RECORD

FORMATION	CONTENT	FROM	TO	SIZE	PUT IN	PULLED OUT
				8-5/8	553	None
				5-1/2	3681	None

Describe in detail the manner in which the well was plugged, indicating where the mud fluid was placed and the method or methods used in introducing it into the hold. If cement or other plugs were used, state the character of same and depth placed, from _____ feet to _____ feet for each plug set.

Plugged well down 5-1/2" casing with 25 sxs lite cement, followed with 4 sxs hulls, 20 sxs of gel, 1 sx hulls, 1 wiper plug, and 100 sxs of cement. Maximum pressure was 100 psi. Shut in pressure was 100 psi. Cementing completed @ 12:30 P.M. 10-30-84. Cement dropped down casing from the surface.

11-1-84 Ran measuring line. Found top of cement at 421'. Dumped 2-1/2 yards redi mix cement down casing. Filled casing to surface. Plugging completed 11-1-84.

(If additional description is necessary, use BACK of this sheet)

Name of Plugging Contractor Halliburton Services

STATE OF Kansas COUNTY OF Barton, ss.
Jim W. Sullivan (employee of owner) or (owner or operator)
of the above-described well, being first duly sworn on oath, says: That I have knowledge of the facts, statements, and matters herein contained and the log of the above-described well as filed and that the same are true and correct. So help me God.


(Signature)

Jim W. Sullivan
925 Patton Rd, Great Bend, KS 67530
(Address)

SUBSCRIBED AND SWORN TO before me this 16th day of November, 1984.

Ronald E. Rowe
Notary Public.

My commission expires My Appt. Exp. Sept. 9, 1987

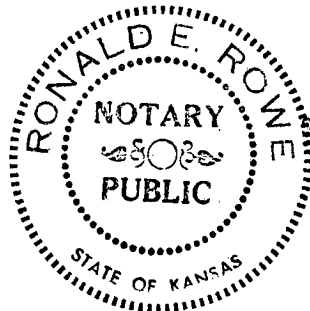

RECEIVED
STATE CORPORATION COMMISSION
NOV 26 1984
11-26-84
CONSERVATION DIVISION
Wichita, Kansas